

LINCOLN
P 39
4-12-72

MISSISSIPPI
 BOARD OF WATER COMMISSIONERS
 416 North State Street
 Jackson, Mississippi 39201

CODED

WATER WELL DRILLERS LOG

April 12 1972 *Chet Keener* *Lincoln*
 date well completed firm name county well located

LANDOWNERS: *Fred Willman*
& F D Baguichillo
 (mailing address)

description of formations encountered	from	to
<i>Red clay</i>	<i>0</i>	<i>12</i>
<i>Sand & gravel</i>	<i>12</i>	<i>37</i>

WELL LOCATION:
 sec. *14* T *5* N R *7* E
1 miles *South* of *Poplar*
 (distance) (direction) (nearest town)

WELL PURPOSE: *Home*
 (home, irrigation, municipal, industrial)

- WELL COMPLETION DATA:
- (1) diameter (inches) *4 3/4"*
 - (2) total depth (feet) *37*
 - (3) static water level (feet) *3* below top of ground.
 - (4) casing *Cast, galv.*
 (material) (depth)
 - _____ if telescope see back.
 (size)
 - (5) screen *6'* *31'*
 (length) (depth to top)
 - 4"* *plastic*
 (size) (material)
 - (6) pump *1/2 HP* *8*
 (HP) (yield gpm)
 - Steel*
 (type power)
 - (7) electric log *No.*
 (yes or no)
 - _____ (organization running log)

CODED

(8) how well bottom plugged *wooden plug*


DRILLERS REMARKS:
New house

APR 30 1972

MISS. F
 CODED

If well telescopes please sketch and show depths.

GROUND LEVEL

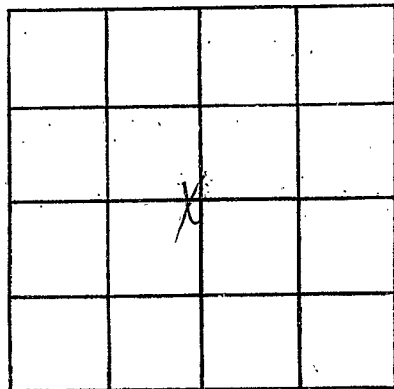

SECTION 14

Please indicate well location X.

ADDITIONAL INFORMATION

If more than one screen, show locations of each on sketch.