

43

LINCOLN
P42
6-21-72

MISSISSIPPI
BOARD OF WATER COMMISSIONERS
416 North State Street
Jackson, Mississippi 39201

CODED

WATER WELL DRILLERS LOG

7/1 June

1972

J. T. Co. Inc. Lincoln

Lincoln

date well completed

firm name

county well located

LANDOWNER:

F. W. Porter

Boque Chitto, Miss.
(mailing address)

description of formations encountered

from

to

Clay	0	20
Chalk	20	40
Sand	40	50
Chalk	50	60
Chalk Sand	60	75
Sand	75	96

WELL LOCATION:

sec. 12 T. 5 N R. 7 E
4 miles W of B. C.
(distance) (direction) (nearest town)

WELL PURPOSE:

(home, irrigation, municipal, industrial)

WELL COMPLETION DATA:

- (1) diameter (inches) 4
- (2) total depth (feet) 96
- (3) static water level (feet) 70 below above top of ground.
- (4) casing PI 90
(material) (depth)
(size) if telescope see back.
- (5) screen 10 90
(length) (depth to top)
4 PI
(size) (material)
- (6) pump 1/2 8
(HP) (yield gpm)
elect
(type-power)
- (7) electric log _____
(yes or no)

CODED

(organization running log)

(8) how well bottom plugged good


DRILLERS REMARKS:

622 1972

If well telescopes please sketch and show depths.

[Faint handwritten notes]

GROUND LEVEL

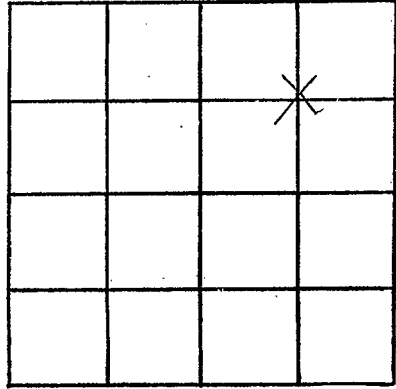

SECTION 12

Please indicate well location X.

ADDITIONAL INFORMATION

Multiple horizontal lines for additional information.

If more than one screen, show locations of each on sketch.