

LINCOLN
P43
7-26-72

MISSISSIPPI
 BOARD OF WATER COMMISSIONERS
 416 North State Street
 Jackson, Mississippi 39201

CODED

WATER WELL DRILLERS LOG

July 26 19 72 Greenwater Well Lincoln
 date well completed firm name county well located

LANDOWNER: E. J. Welch
Rt 3 Box 255
Bogue Chitto Miss
 (mailing address)

description of formations encountered	from	to
<u>clay red sand & gravel</u>	<u>0</u>	<u>124</u>
<u>clay</u>	<u>124</u>	<u>140</u>

WELL LOCATION:
 sec. 10 T. 5 N. R. 7 E.
10 miles S of Brookhaven
 (distance) (direction) (nearest town)

WELL PURPOSE: home
 (home, irrigation, municipal, industrial)

- WELL COMPLETION DATA:
- (1) diameter (inches) 6
 - (2) total depth (feet) 140
 - (3) static water level (feet) 60 below above top of ground.
 - (4) casing PVC, 114,
 (material) (depth)
4"
 (size) if telescope see back.
 - (5) screen 6', 114
 (length) (depth to top)
0/0, PVC
 (size) (material)
 - (6) pump did not
 (HP) (yield gpm)
install
 (type power)
 - (7) electric log no
 (yes or no)
 (organization running log)
 - (8) how well bottom plugged Wood

CODED


SEP 27 1972
 SEP 21 1972

DRILLERS REMARKS:

MISS. BD. OF
 WATER COMMISSIONERS

If well telescopes please sketch and show depths.

GROUND LEVEL

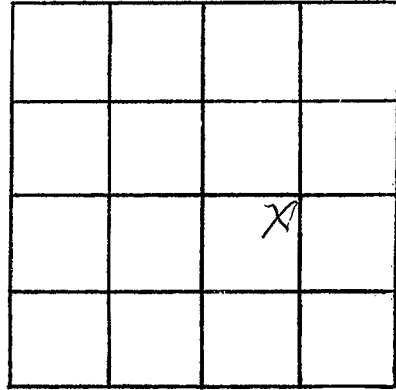

SECTION 10

Please indicate well location X.

ADDITIONAL INFORMATION

If more than one screen,
show locations of each on sketch.