

LINCOLN
P 44
3-13-73

MISSISSIPPI
BOARD OF WATER COMMISSIONERS
416 North State Street
Jackson, Mississippi 39201

CODED

WATER WELL DRILLERS LOG


13 March 1973 J.P. Compton Lincoln
date well completed firm name county well located

LANDOWNER:	description of formations encountered	from	to
W Woodbowl Bogal Chitto (mailing address)	Clay Red sand Clay sand	0 20 35 60	70 35 60 95
WELL LOCATION: sec <u>20</u> T <u>5</u> N R <u>2</u> E <u>6</u> miles <u>N</u> of <u>Summit</u> (distance) (direction) (nearest town)			
WELL PURPOSE: (home, irrigation, municipal, industrial)			
WELL COMPLETION DATA:			
(1) diameter (inches) <u>4</u>			
(2) total depth (feet) <u>95</u>			
(3) static water level (feet) <u>60</u> below above top of ground			
(4) casing <u>PI</u> <u>89</u> (material) (depth)			
_____ If telescope see back. (size)			
(5) screen <u>6</u> <u>89</u> (length) (depth to top)			
_____ <u>PI</u> (size) (material)			
(6) pump <u>1/2</u> <u>8</u> (HP) (yield gpm)			
<u>elect</u> (type power)			
(7) electric log _____ (yes or no)			
_____ (organization running log)			
(8) how well bottom plugged <u>wood</u>			
DRILLERS REMARKS: _____ _____ _____			

CODED

If well telescopes please sketch and show depths.

GROUND LEVEL

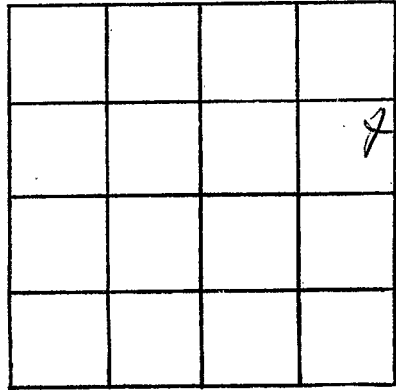

SECTION 2A

Please indicate well location X.

ADDITIONAL INFORMATION

A series of 20 horizontal lines provided for entering additional information.

If more than one screen, show locations of each on sketch.