

P 45
 LINCOLN
 4-12-73

MISSISSIPPI
 BOARD OF WATER COMMISSIONERS
 416 North State Street
 Jackson, Mississippi 39201

CODED

WATER WELL DRILLERS LOG

April 12 1973 Chester Keener Lincoln
 date well completed firm name county well located

LANDOWNER: Edgar Adams
 Bogochitto

description of formations encountered	from	to
clay gravel	0	14
sand gravel	14	29
white & blue chalk	29	212
coarse sand	212	261

(mailing address)

WELL LOCATION:

sec. 12 T. 50 N R. 7 E
 1 miles S of Bogochitto
 (distance) (direction) (nearest town)

WELL PURPOSE: Home
 (home, irrigation, municipal, industrial)

WELL COMPLETION DATA:

- (1) diameter (inches) 4"
- (2) total depth (feet) 261
- (3) static water level (feet) 50 below top of ground
- (4) casing Plast bottom
 (material) (depth)
- _____ If telescope see back.
 (size)
- (5) screen 6' 255'
 (length) (depth to top)
- 4" Plast
 (size) (material)
- (6) pump 1/2 hp 3
 (HP) (yield gpm)
- elect
 (type power)
- (7) electric log no
 (yes or no)

CODED

(organization running log)


(8) how well bottom plugged
was plugged

DRILLERS REMARKS:
 new house

AUG 20 1973

If well telescopes please
sketch and show depths.

GROUND LEVEL

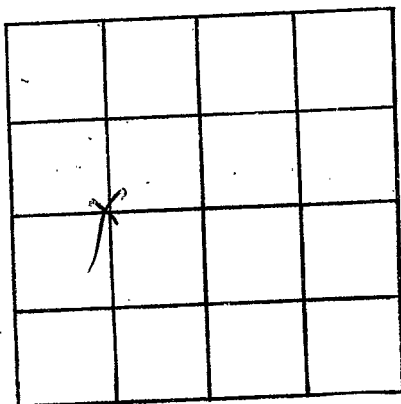

SECTION 12

Please indicate well location X.

ADDITIONAL INFORMATION

If more than one screen,
show locations of each on sketch.