

P 46
 LINCOLN
 6-73

MISSISSIPPI
 BOARD OF WATER COMMISSIONERS
 416 North State Street
 Jackson, Mississippi 39201

CODED

WATER WELL DRILLERS LOG

Jan 31 1973 *Chatterboxes* Lincoln
 (date well completed) (firm name) (county well located)

LANDOWNER: *Donnell*
Mr. Nable
Boquechitto
 (mailing address)

description of formations encountered	from	to
clay	0	24
red sand	24	72
coarse sand	72	80
no circulation return	80	83

WELL LOCATION:
 sec. 2 T 5 N R 7 E
1 miles WSW *Boquechitto*
 (distance) (direction) (nearest town)

WELL PURPOSE: *house*
 (home, irrigation, municipal, industrial)

CODED

- WELL COMPLETION DATA:
- (1) diameter (inches) 4 1/2
 - (2) total depth (feet) 83
 - (3) static water level (feet) 52 below top of ground.
 - (4) casing Plast Ballam
 (material) (depth)
 - (size) if telescope see back.
 - (5) screen 6' 77'
 (length) (depth to top)
 - 1/2" Plast
 (size) (material)
 - (6) pump 1/2 HP 5
 (HP) (yield gpm)
 - Elect
 (type power)
 - (7) electric log NO
 (yes or no)

(organization running log)


(8) how well bottom dug wooden plug

DRILLERS REMARKS:
New house

AUG 20 1973

If well telescopes please sketch and show depths.

GROUND LEVEL

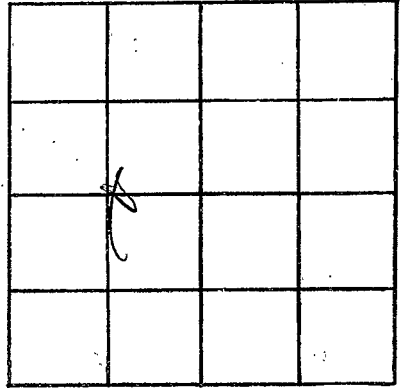

SECTION 11

Please indicate well location X.

ADDITIONAL INFORMATION

If more than one screen,
show locations of each on sketch.