

LINCOLN

P47

7-20-73

MISSISSIPPI BOARD OF WATER COMMISSIONERS
416 North State Street
Jackson, Mississippi 39201

CODED

MISS. BD. OF WATER COMMISSIONERS

WATER WELL DRILLERS LOG

20 July 1973
date well completed

73

J. T. Conroy & Sons
firm name

Lincoln
county well located

LANDOWNER:

Rev. E. H. Blumer

Rt. 3 Bogue Chitto
(mailing address)

WELL LOCATION:

sec 30 T 5 N R 7 E
S W

9 miles N of Summit
(distance) (direction) (nearest town)

WELL PURPOSE:

(home, irrigation, municipal, industrial)

WELL COMPLETION DATA:

- (1) diameter (inches) 4
- (2) total depth (feet) 112
- (3) static water level (feet) 70 below top of ground
- (4) casing (material) PL (depth) 1.06
- (5) screen (length) 6 (depth to top) 1.06
- (6) pump (HP) 1/2 (yield gpm) 8
- (7) electric log (yes or no)

(organization running log)

(8) how well bottom plugged wood

DRILLERS REMARKS:

description of formations encountered


from to

clay dirt	0	25
Chalk	35	60
Sand & Pea gravel	60	85
chalk	85	90
sand & Pea gravel	90	112

CODED

If well telescopes please sketch and show depths.

GROUND LEVEL

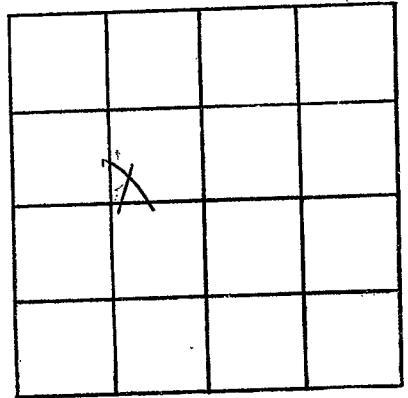

SECTION 30

Please indicate well location X.

ADDITIONAL INFORMATION

If more than one screen, show locations of each on sketch.