

LINCOLN  
P 48  
10-11-73

MISSISSIPPI  
BOARD OF WATER COMMISSIONERS CODED  
416 North State Street  
Jackson, Mississippi 39201

WATER WELL DRILLERS LOG

Oct 11 1973 Chester Keenes Lincoln  
date well completed firm name county well located

LANDOWNER: Winifred Mack  
RT 4  
Summit  
(mailing address)

WELL LOCATION:  
sec. 34 T. 5 N R. 7 E  
5 miles NW of Summit  
(distance) (direction) (nearest town)

WELL PURPOSE: domest  
(home, irrigation, municipal, industrial)

WELL COMPLETION DATA:

(1) diameter (inches) 4 1/2

(2) total depth (feet) 70

(3) static water level (feet) 35 below top of ground.

(4) casing Plast (material) Bottom (depth)

\_\_\_\_\_ if telescope see back.  
(size)

(5) screen 6' (length) 64' (depth to top)

4" (size) Plast (material)

(6) pump old pump (HP) owned (yield gpm)

(type power)

(7) electric log No (yes or no)

\_\_\_\_\_ (organization running log)

description of formations encountered	from	to
Sandy clay	0	14
sand & gravel	14	36
brown kaol	36	42
Sand & gravel	42	70

CODED


(8) how well bottom plugged wood plug

DRILLERS REMARKS: all well pumped dry

NOV 7 1973  
MISS. BU. OF  
MINES

If well telescopes please sketch and show depths.

GROUND LEVEL

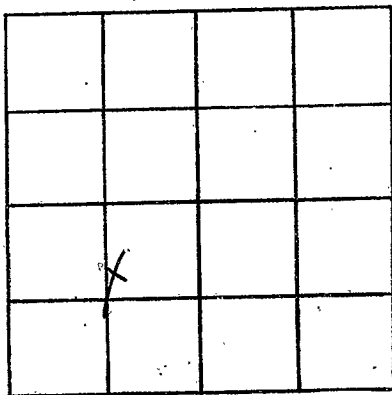

SECTION 34

Please indicate well location X.

ADDITIONAL INFORMATION

If more than one screen, show locations of each on sketch.