

LINCOLN  
P 49  
12-6-73

MISSISSIPPI  
BOARD OF WATER COMMISSIONERS CODED  
416 North State Street  
Jackson, Mississippi 39201  
WATER WELL DRILLERS LOG

6 Dec 1973 date well completed  
J.T. Constance firm name  
county well located

LANDOWNER:  
L.G. Adams  
Bogue Bluffs  
(mailing address)

WELL LOCATION:  
sec 36 T 5 N R 7 E  
6 miles N of Summit  
(distance) (direction) (nearest town)

description of formations encountered	from	to
clay	0	25
chalk	25	60
red ch. COD	60	70
chalk	70	85
red	85	114

WELL PURPOSE:  
(home, irrigation, municipal, industrial)

WELL COMPLETION DATA:

(1) diameter (inches) ~~4~~ 4

(2) total depth (feet) 114

(3) static water level (feet) 85 below above top of ground.

(4) casing PL 107 (material) (depth)

(size) if telescope see back.

(5) screen 6 107 (length) (depth to top)

4 PL (size) (material)

(6) pump 1/2 5 (HP) (yield gpm)

Elect (type power)

(7) electric log (yes or no)

(organization running log)


(8) how well bottom plugged mud

DRILLERS REMARKS:

FEB 10 1974  
MISSISSIPPI BOARD OF WATER COMMISSIONERS

If well telescopes please sketch and show depths.

GROUND LEVEL

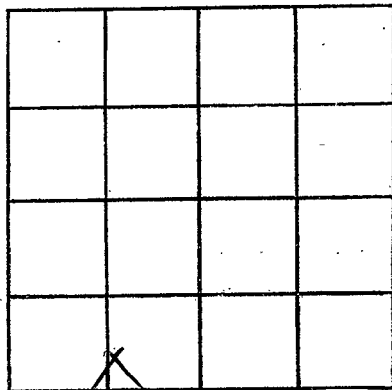

SECTION 36

Please indicate well location X.

ADDITIONAL INFORMATION

If more than one screen, show locations of each on sketch.