

LINCOLN
P 50
4-1-74

MISSISSIPPI
 BOARD OF WATER COMMISSIONERS
 416 North State Street
 Jackson, Mississippi 39201

CODED

WATER WELL DRILLERS LOG

Lincoln
~~74~~

April 1 1974 J. T. Corcoran & Son Lincoln
 date well completed firm name county well located

LANDOWNER:
Charles Mook
 (mailing address)

description of formations encountered	from	to
<u>Clay</u>	<u>0</u>	<u>20</u>
<u>red clay</u>	<u>20</u>	<u>25</u>
<u>Chalk</u>	<u>25</u>	<u>50</u>
<u>Gravel</u>	<u>50</u>	<u>74</u>

WELL LOCATION:
 sec. 33 T 5 N R. 7 E
5 miles N of Summit
 (distance) (direction) (nearest town)

WELL PURPOSE:
 (home, irrigation, municipal, industrial)

- WELL COMPLETION DATA:**
- (1) diameter (inches) 4
 - (2) total depth (feet) 74
 - (3) static water level (feet) 55 below above top of ground.
 - (4) casing PI 68
 (material) (depth)
 (size) If telescope see back.
 - (5) screen 6 88
 (length) (depth to top)
4 PI
 (size) (material)
 - (6) pump 1/2 8
 (HP) (yield gpm)
glad
 (type power)
 - (7) electric log _____
 (yes or no)
 - _____ (organization running log)
 - (8) how well bottom plugged wood

CODED



REGISTERED

MAY 1 0 1974

DRILLERS REMARKS:

If well telescopes please sketch and show depths.

GROUND LEVEL

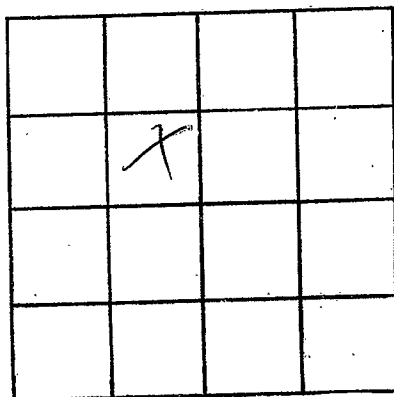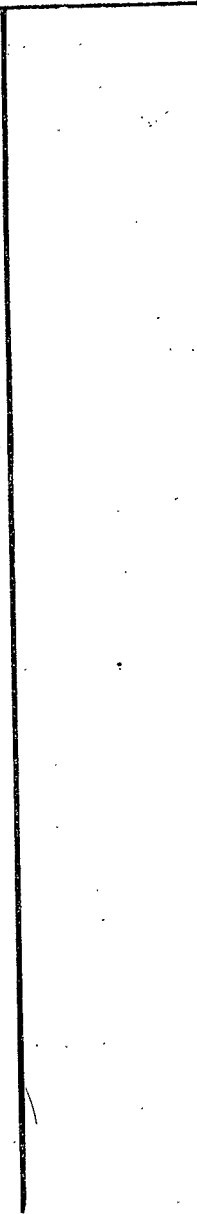

SECTION 33

Please indicate well location X.

ADDITIONAL INFORMATION

Lined area for additional information.

If more than one screen, show locations of each on sketch.