

LINCOLN
P 51
2-19-74

MISSISSIPPI
BOARD OF WATER COMMISSIONERS
416 North State Street
Jackson, Mississippi 39201

CODED

WATER WELL DRILLERS LOG

Feb. 19 1974 Grenn W. W. Bout. Lincoln
date well completed firm name county well located

LANDOWNER:

Russell Sasser

description of formations encountered

from to

Bogue Chitto Miss.
(mailing address)

Citronelle

0 79

WELL LOCATION:

sec. 7 T 5 N R 7 E
S W
6 miles W of Bogue Chitto
(distance) (direction) (nearest town)

WELL PURPOSE:

Home
(home, irrigation, municipal, industrial)

WELL COMPLETION DATA:

- (1) diameter (inches) 6"
- (2) total depth (feet) 79'
- (3) static water level (feet) 15 below above top of ground.
- (4) casing PVC, 73',
(material) (depth)
4" if telescope see back.
(size)
- (5) screen 6', 73'
(length) (depth to top)
10/0, PVC
(size) (material)
- (6) pump Did not install
(HP) (yield gpm)

(type power)
- (7) electric log no
(yes or no)

(organization running log)
- (8) how well bottom plugged wood


CODED

DRILLERS REMARKS:

APR 30 1974
MISS. Bd. OF WATER COM.

If well telescopes please sketch and show depths.

GROUND LEVEL

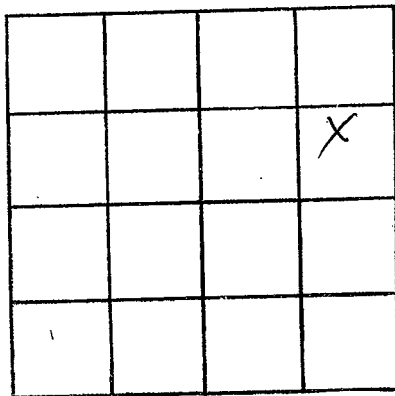

SECTION 7

Please indicate well location X.

ADDITIONAL INFORMATION

If more than one screen, show locations of each on sketch.