

Lynch
 P 54
 8-15-75

MISSISSIPPI
 BOARD OF WATER COMMISSIONERS CODED
 416 North State Street
 Jackson, Mississippi 39201

WATER WELL DRILLERS LOG

15 Aug 1975 *J.T. Crayton* *Lynch*
 date well completed firm name county well located

LANDOWNER:
Grace Brown
Boze Chitto
 (mailing address)


description of formations encountered	from	to
<i>Clay</i>	<i>0</i>	<i>75</i>
<i>Clay</i>	<i>25</i>	<i>40</i>
<i>Sand shell</i>	<i>40</i>	<i>65</i>
<i>Sand</i>	<i>65</i>	<i>95</i>

WELL LOCATION:
 sec. *32* T. *5* N. R. *7* E. *1321*
6 miles *NW* of *Summit*
 (distance) (direction) (nearest town)

WELL PURPOSE:
 (home, irrigation, municipal, industrial)

- WELL COMPLETION DATA:
- (1) diameter (inches) *4*
 - (2) total depth (feet) *95*
 - (3) static water level (feet) *70* below top of ground.
 - (4) casing *PI* *89*
 (material) (depth)
 (size) if telescope see back.
 - (5) screen *6* *89*
 (length) (depth to top)
4 *PI*
 (size) (material)
 - (6) pump *K* *8*
 (HP) (yield gpm)
split
 (type power)
 - (7) electric log _____
 (yes or no)
 - (8) how well bottom plugged *wood*


DRILLERS REMARKS:

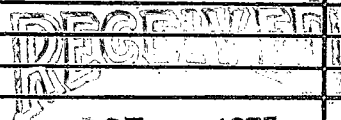

OCT - 6 1975

If well telescopes please sketch and show depths.

GROUND LEVEL

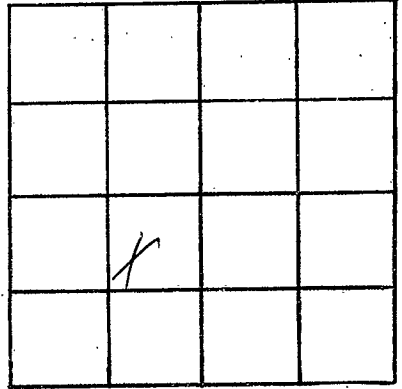

SECTION 32

Please indicate well location X.

ADDITIONAL INFORMATION

If more than one screen, show locations of each on sketch.