

MISSISSIPPI DEPARTMENT OF NATURAL RESOURCES

Bureau of Land and Water Resources

Southport Mall

P.O. Box 10631

Jackson, Mississippi 39209

WATER WELL DRILLERS LOG

Griner Drilling Service, Inc.

Lincoln

LINCOLN
P 55
126/83

1-26-83 date well completed

Griner Drilling Service, Inc. firm name

Lincoln county well located

LANDOWNER:	description of formations encountered	from	to
Rapid Drilling P.O. Box 447 Laurel, Ms. 39440 (mailing address)			
WELL LOCATION: 1763'54" + 1760' E sec. 11 T 5 N R 7 E NW/40 et al. in care of Boque Chitto 11-6 (distance) miles (direction) of (nearest town)	sand, gravel, clay	42	84
WELL PURPOSE: oil field sand (home, irrigation, municipal, industrial)	chalk	84	231
WELL COMPLETION DATA:	sand	231	294
(1) diameter (inches) 4"	chalk, sand	294	315
(2) total depth (feet) 546'	sand, chalk	315	546
(3) static water level (feet) 80' (below above top of ground)			
(4) casing steel, 294' (material), (depth) 4" (size) if telescope see back.			
(5) screen 42' 252' (length), (depth to top) 4" perforated (size), (material)			
(6) pump - 75 (HP), (yield gpm) AC (type power)			
(7) electric log (yes or no)			
(organization running log)			
(8) how well bottom plugged orange peel			
DRILLERS REMARKS:			

CODED


DEPT. OF NATURAL RESOURCES
BUREAU OF LAND & WATER RESOURCES

JAN 31 1983

RECEIVED

If well telescopes please sketch and show depths.

GROUND LEVEL

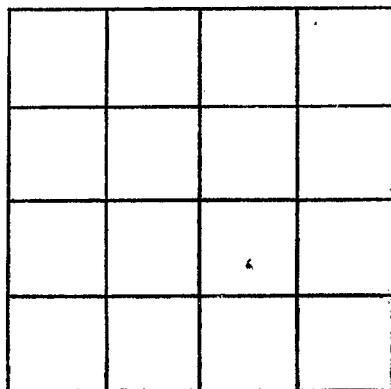

SECTION _____

Please indicate well location X.

ADDITIONAL INFORMATION

If more than one screen,
show locations of each on sketch.