

MISSISSIPPI DEPARTMENT OF NATURAL RESOURCES

Bureau of Land and Water Resources

Southport Mall

P.O. Box 10631

Jackson, Mississippi 39209

WATER WELL DRILLERS LOG

CODED

P56  
Lincoln Co.  
10-11-83

Griner Drilling Service, Inc.

Lincoln

10-11-83  
date well completed

Griner Drilling Service, Inc.  
firm name

Lincoln  
county well located

LANDOWNER:	description of formations encountered:	from	to
Delta Drilling P.O. Drawer 52787 Lafayette, La 70505 (mailing address)	sand, large gravel	0	50
	chalk	50	240
WELL LOCATION: 1860' N & 1625' W sec. 23-T-5 N R-7E of No. 1 Ernest Reservoir Ernest Reservoir (distance) miles (direction) (nearest town)	sand - medium	240	294
	Chalk	294	399
WELL PURPOSE: oil field supply (home, irrigation, municipal, industrial)	fine sand	399	441
WELL COMPLETION DATA:			
(1) diameter (inches) 3"			
(2) total depth (feet) 441'			
(3) static water level (feet) 40' below top of ground.			
(4) casing steel, 294' (material), (depth)			
8" (size) if telescope see back.			
(5) screen 42' (length), 252' (depth to top)			
3" perforated (size), (material)			
(6) pump — 70 (HP), (yield gpm)			
AC (type power)			
(7) electric log — (yes or no)			
(organization running log)			
(8) how well bottom plugged — Orange peel			
DRILLERS REMARKS:			


CODED

DEPT. OF NATURAL RESOURCES  
BUREAU OF LAND & WATER RESOURCES

NOV 29 1983  
RECEIVED

If well telescopes please sketch and show depths.

GROUND LEVEL

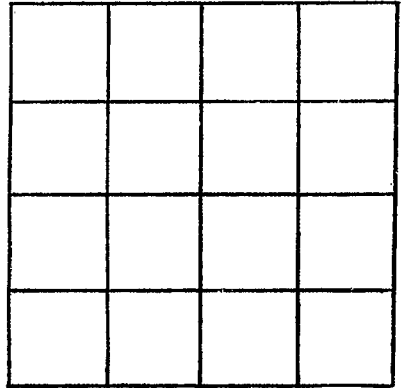

SECTION \_\_\_\_\_

Please indicate well location X.

ADDITIONAL INFORMATION

If more than one screen, show locations of each on sketch.