

MISSISSIPPI DEPARTMENT OF NATURAL RESOURCES

Bureau of Land and Water Resources

Southport Mall

P.O. Box 10631

Jackson, Mississippi 39209

WATER WELL DRILLERS LOG

CODED

P57  
Lincoln Co.  
10-26-83

10-26-83

Griner Drilling Service, Inc.

Lincoln

date well completed

firm name

county well located

LANDOWNER:	description of formations encountered	from	to
Samedan Oil Corp. 212 Loyola Suite 1400 Sartota Bldg. New Orleans, La. 70112	sand, gravel	0	189'
WELL LOCATION: 550' S of 780' W No. 30 T-5 N R-2 E NE 1/4 Henry Summit Freeman miles (direction) (nearest town)	NE 1/4, NE 1/4		
WELL PURPOSE: oilfield supply (home, irrigation, municipal, industrial)			
WELL COMPLETION DATA:			
(1) diameter (inches) 3"			
(2) total depth (feet) 189'			
(3) static water level (feet) 30' below top of ground.			
(4) casing Steel 189' (material) (depth)			
3" (size) if telescope see back.			
(5) screen 42' 147' (length) (depth to top)			
3" perforated (size) (material)			
(6) pump - 30 (HP) (yield gpm)			
AC (type power)			
(7) electric log - (yes or no)			
(organization running log)			
(8) how well bottom plugged Orange peel			

CODED

DEPT. OF NATURAL RESOURCES  
BUREAU OF LAND & WATER RESOURCES


NOV 29 1983

RECEIVED

DRILLERS REMARKS:

If well telescopes please sketch and show depths.

GROUND LEVEL

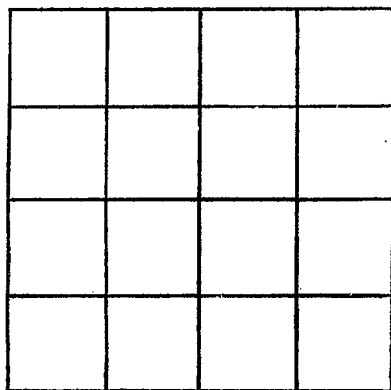

SECTION \_\_\_\_\_

Please indicate well location X.

ADDITIONAL INFORMATION

If more than one screen, show locations of each on sketch.