

MISSISSIPPI DEPARTMENT OF NATURAL RESOURCES

Bureau of Land and Water Resources

Southport Mall

P.O. Box 10631

Jackson, Mississippi 39209

WATER WELL DRILLERS LOG

P58
LINCOLN
5-10-84

CODED

5-10-84 *Griner Drilling Service, Inc.* Lincoln
 date well completed firm name county well located

LANDOWNER:	description of formations encountered	from	to
<i>Wolfe and Magee</i> <i>High 61 North</i> <i>Natchez, Ms. 39120</i> (mailing address)			
WELL LOCATION: <i>2000'S + 1950'E</i>	<i>clay</i>	<i>84</i>	<i>260</i>
sec. <i>6</i> T. <i>5(N)</i> R. <i>7(E)</i> of <i>W. Union</i>	<i>sand, gravel</i>	<i>260</i>	<i>294</i>
<i>NO. 1</i> <i>Rever</i> <i>1/2</i> mile <i>ROQUE CHITTO</i> <i>Time</i> (distance) (direction) (nearest town)	<i>clay</i>	<i>294</i>	<i>336</i>
WELL PURPOSE: <i>oil field supply</i> (home, irrigation, municipal, industrial)			
WELL COMPLETION DATA:			
(1) diameter (inches) <i>3"</i>			
(2) total depth (feet) <i>336'</i>			
(3) static water level (feet) <i>70'</i> <i>below</i> top of ground.			
(4) casing <i>Steel, 294'</i> (material) (depth)			
<i>3"</i> (size) if telescope see back.			
(5) screen <i>42', 252'</i> (length) (depth to top)			
<i>3"</i> <i>perforated</i> (size) (material)			
(6) pump <i>-</i> <i>75</i> (HP) (yield gpm)			
<i>AC</i> (type power)			
(7) electric log <i>-</i> (yes or no)			
<i>-</i> (organization running log)			
(8) how well bottom plugged <i>orange peel</i>			
DRILLERS REMARKS:			


DEPT. OF NATURAL RESOURCES
BUREAU OF LAND & WATER RESOURCES

MAY 21 1984

RECEIVED

If well telescopes please sketch and show depths.

GROUND LEVEL

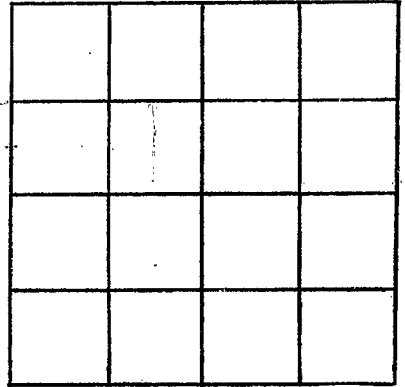

SECTION _____

Please indicate well location X.

ADDITIONAL INFORMATION

If more than one screen, show locations of each on sketch.