

LINCOLN
P59
4-18-85

MISSISSIPPI DEPARTMENT OF NATURAL RESOURCES
Bureau of Land and Water Resources
Southport Mall
P.O. Box 10631
Jackson, Mississippi 39209
WATER WELL DRILLERS LOG

April 18 19 85 Green Water Well Lincoln
date well completed firm name county well located

LANDOWNER: Ken Wallace Rt. 3, Box 228 Bogue Chitto, Ms. (mailing address)	description of formations encountered Citronelle	from 1	to 76
WELL LOCATION:			
sec. 10 T. 5 N R. 7 E			
2 miles SW of Bogue Chitto (distance) (direction) (nearest town)			
WELL PURPOSE: home (home, irrigation, municipal, industrial)			
WELL COMPLETION DATA:			
(1) diameter (inches) 4			
(2) total depth (feet) 76			
(3) static water level (feet) 30 below above top of ground.			
(4) casing PVC 66 (material) (depth) 4" If telescope see back. (size)			
(5) screen 10' 66' (length) (depth to top) .0109 PVC (size) (material)			
(6) pump 1/2 sub 8 (HP) (yield gpm) electricity (type power)			
(7) electric log no (yes or no) (organization running log)			
(8) how well bottom plugged back wash valve			

RECEIVED


MAY 17 1985

Department of Natural Resources
Bureau of Land & Water Resources

DRILLERS REMARKS:

If well telescopes please sketch and show depths.

GROUND LEVEL

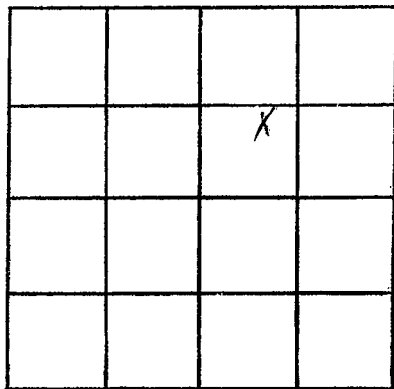

SECTION 10

Please indicate well location X.

ADDITIONAL INFORMATION

If more than one screen, show locations of each on sketch.