

MISSISSIPPI DEPARTMENT OF NATURAL RESOURCES

Bureau of Land and Water Resources

Southport Mall

P.O. Box 10631


Jackson, Mississippi 39209

WATER WELL DRILLERS LOG

| |
|---------|
| LINCOLN |
| P 60 |
| 9-4-86 |

SEPT 4 1986 HERNDON WELLS - SUPPLY, INC. LINCOLN
 date well completed firm name county well located

| LANDOWNER: BOGUE CHITTO | description of formations encountered | from | to |
|--|---------------------------------------|------|------|
| WATER ASSN. P.O. BOX 101 | | | |
| BOGUE CHITTO, MS. (mailing address) | red clay | 0 | 15 |
| WELL LOCATION: sec 1 T 5 N R 7 E | gravel | 15 | 60 |
| (distance) miles (direction) of (nearest town) | blue clay | 60 | 210 |
| WELL PURPOSE: municipal (home, irrigation, municipal, industrial) | sand | 210 | 230 |
| WELL COMPLETION DATA: | clay | 230 | 265 |
| (1) diameter (inches) 12 | sand + gravel | 265 | 305 |
| (2) total depth (feet) 1350 | clay | 305 | 335 |
| (3) static water level (feet) _____ below above top of ground. | sand | 335 | 360 |
| (4) casing STEEL, 1270 (material), (depth) | blue clay | 360 | 400 |
| 12" If telescope see back. (size) | silt - fine sand | 400 | 440 |
| (5) screen 60.81, 1270 (length), (depth to top) | silty clay | 440 | 540 |
| 6 STAINLESS STEEL (size), (material) | fine sand | 540 | 570 |
| (6) pump 75, 400 (HP), (yield gpm) | clay | 570 | 590 |
| ELECTRIC (type power) | sand | 590 | 665 |
| (7) electric log YES (yes or no) | silty clay | 665 | 1100 |
| HERNDON WELLS - SUPPLY, INC. (organization running log) | clay | 1100 | 1140 |
| (8) how well bottom plugged BACKWARDS A VALVE | rock | 1140 | 1141 |
| | clay | 1141 | 1150 |
| | rock | 1150 | 1151 |
| | clay | 1151 | 1160 |
| | sand | 1160 | 1200 |
| | clay | 1200 | 1220 |
| | hard sand + rock | 1220 | 1240 |
| | clay | 1240 | 1290 |
| | sand | 1290 | 1370 |
| | clay | 1370 | 1400 |

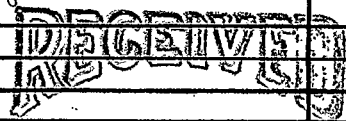

OCT 28 1986


Department of Natural Resources
 Bureau of Land & Water Resources

12/1/86
 135

DRILLERS REMARKS:

If well telescopes please sketch and show depths.

GROUND LEVEL

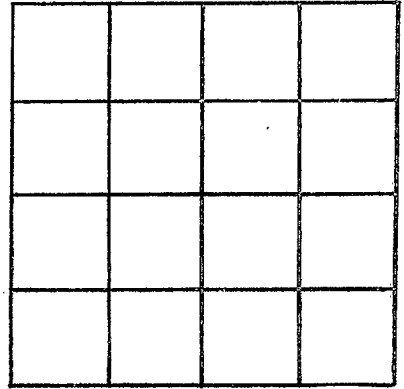

SECTION _____

Please indicate well location X.

ADDITIONAL INFORMATION

If more than one screen,
show locations of each on sketch.