

MISSISSIPPI DEPARTMENT OF NATURAL RESOURCES

Bureau of Land and Water Resources

Southport Mall

P.O. Box 10631

Jackson, Mississippi 39209

WATER WELL DRILLERS LOG

Griner Drilling Service, Inc.

Lincoln

CODED

Lincoln
P63

9-23-88 date well completed

Griner Drilling Service, Inc. firm name

Lincoln county well located

LANDOWNER:

Helmerich And Payne
P.O. Box 6173
Pearl, Ms. 39208
(mailing address)

description of formations encountered

SAND
PEAR GRAVEL

from

to

0 200

WELL LOCATION: 960'S + 2140' W

sec. 19 T. 5^N R. 7^E OF

No. 1 ley Bogue chitto
5 mi (distance) N (direction) of (nearest town)

WELL PURPOSE: oilfield
(home, irrigation, municipal, industrial)

WELL COMPLETION DATA:

(1) diameter (inches) 4"

(2) total depth (feet) 200'

(3) static water level (feet) 56' ^{below} _{above} top of ground.

(4) casing PVC 170' (material) (depth)
4" (size) If telescope see back.

(5) screen 20' 150' (length) (depth to top)

4" PVC SCREEN (size) (material)

(6) pump 7 1/2 80 (HP) (yield gpm)

230 volt 3phase (type power)

(7) electric log (yes or no)

(organization running log)

(8) has well bottom plugged 4" BACKWASH VALVE

DRILLERS REMARKS:


RECEIVED

NOV 11 1988

Department of Natural Resources
Bureau of Land & Water Resources

If well telescopes please sketch and show depths.

GROUND LEVEL

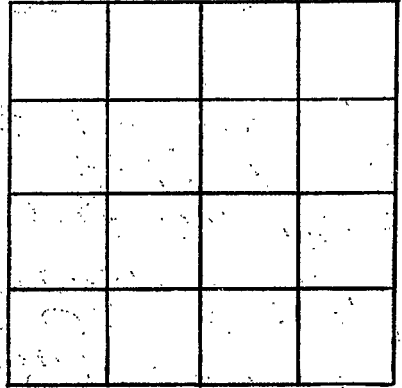

SECTION _____

Please indicate well location X.

ADDITIONAL INFORMATION

If more than one screen, show locations of each on sketch.