

MISSISSIPPI DEPARTMENT OF ENVIRONMENTAL QUALITY

Office of Land and Water Resources

P. O. Box 10631
 Jackson, MS 39289-0631
WATER WELL DRILLERS LOG

COUNTY WELL LOCATED
LINCOLN

WELL NUMBER CODED
P-71

DATE WELL COMPLETED
3/18/04

PERMIT NUMBER

NAME OF DRILLING FIRM
Green Water Well & Supply, Inc.

NAME & MAILING ADDRESS OF LANDOWNER
Allen Cupit
2553 Big Creek Dr., Boguc Chitto

Latitude:
 Longitude:

WELL LOCATION: SEC **10** TOWNSHIP **5** RANGE **7**
 (N) (S) (E) (W)

DISTANCE **2** Miles DIRECTION **SW** of **Boguc Chitto** NEAREST TOWN

OTHER LANDMARK

WELL PURPOSE: Home, Irrigation, Municipal, Industrial, Fish Pond, etc.

PUMP DATA

PUMP TYPE (Circle One):
 Submersible Turbine, Jet Flowing Well,
 Other (Describe)

POWER TYPE (Circle One):
 Electric Tractor, Diesel, Gasoline, Butane,
 Other (Describe) H/P **0.5**

DESCRIPTION OF FORMATIONS ENCOUNTERED	FROM	TO
red clay	0	20
sand	20	50
streaky	50	90
sand & gravel	90	121
white clay	121	125

WELL DATA

Well Depth 120	Casing Diameter (In.) 4	Casing Length (Ft.) 110
Type of Casing PVC	Hole Depth 125	Depth to Static Water Level 65

TYPE OF COMPLETION: (Circle One or More):
 Gravel Packed, Underreamed, Telescoped,
 Natural Development, Open Hole, Other
 (Describe)

WELL GROUTED TO A DEPTH OF **10 FEET**

Type Grout (circle one): Cement, Bentonite, or Mix

SCREEN DATA

Diameter - Inches 4	Length - Feet 10	Slot Size - Inches .010
Screen Type PVC	Depth to Bottom - Feet 120	

RECEIVED

APR 15 2004

BY: OLR

Top of Lap Pipe or Reduction in Casing

FEET IF TELESCOPED OR MORE THAN ONE SCREEN: USE BACK PAGE


I certify that the well was drilled, constructed and completed in accordance with all applicable Requirements of the Mississippi Department of Environmental Quality and/or the Mississippi Department of Health regulations and state laws.

Brian McCloudon 664
 Signature of Licensed Driller and License No.

3/18/04
 Date

If well telescopes please sketch and show depths.

GROUND LEVEL

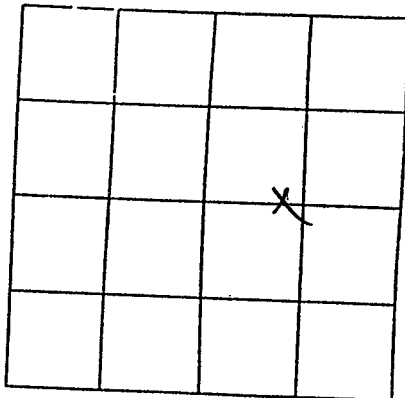

SECTION 10

Please indicate well location X.

Pump Capacity (GPM)	No. of Stages	Setting Depth
<u>10</u>	<u>12</u>	<u>90</u> FT.
PUMP TEST		
Well yielded <u>12</u> GPM with a drawdown of <u>1</u> ft. after <u>1</u> hours of pumping		

LOG DATA

TYPE OF LOG RUN (Circle One):
Electric, Gamma Ray, Density, Sonic, Neutron, Other (Describe) No Log Run.

Name of Organization Running Log

GEOLOGIC DATA (Office Use Only)

Surface Elev.	Geologic Unit	Unit Thickness	Depth to Top
Subs. SWL	Date	Analysis	Aquifer Test

Driller's Remarks

If more than one screen, show location of each on sketch.