County: Licolo. Part 1 – Driller's Log For Office Use Only: Permit #. Mississippi Department of Environmental Quality Aquifer: Driller: Fragerici, Id P.O. Box 10631	······································	State Well Report	
Permain #. Mississippi Department of Environmental Quality Aquifer: Dritler Flagter, Id Office of Land and Water Resources P.O. Box 10631 Date duiting completed: G20 c05 (601)961-5210 L.S. Elevation. State Law requires that this report be prepared by the license holder responsible for the work and filed with the Department of the above address within 30 days of completion of drilling of the well or borehole. L.S. Elevation. Department of the above address within 30 days of completion of drilling of the work and filed with the Department of borehole Location Laitude: 31 * 32. 58 *. Longitude '6 * 32 * 36 Maining Address Emr./ Lowel. Usage address within a water well) Dwner Name Malke Call Owner Laitude: 31 * 32. 58 *. Longitude '6 * 32 * 36 Maining Address Emr./ Lowel. UsGS quad. Hand-held GPS. Survey-grade GPS State Zip Code Net /6 * 0 * 0 * 27 * 36 Maine of organization running Borger Net /6 * 0 * 0 * 0 * 0 * 0 * 0 * 0 * 0 * 0 *	County Licola.	•	For Office Use Only:
Permi #	county		Quality Aquifer:
Diller Flycer P.O. Box 10631 Date drilling completed: Date drilling com	Permit #	Office of Land and Water Resources	D-72
Date drifting completed \$20-05 [0:01)961-5210 State Law requires that this report be prepared by the license holder responsible for the work and filed with the Department at the above address within 30 days of completion of drilling of the work and filed with the Department at the above address within 30 days of completion of drilling of the work and filed with the Department at the above address within 30 days of completion of drilling of the work and filed with the Department at the above address within 30 days of completion of drilling of the work and filed with the Department at the above address within 30 days of completion of drilling of the work and filed with the Department at the above address within 30 days of completion of drilling of the work and filed with the Department at the above address within 30 days of completion of drilling of the work and filed with the Department at the above of back [10:10] Well Above II (construction of drilling of the work and filed with the Department at the above of back [10:10] Well Above II (construction of drilling of the work and filed with the Department at the above of back [10:10] Well Above II (construction of drilling of the source of any surface water used for drilling. Method of dosing and volume of Chlorne used in drilling and evelopment: Location of the source of low regulation. Valve [10] Well Above II (check one): Water Well (Geotechnical Geological Investigation [10] Seismic Survey_Other (describe) [11] If a flowing well, method of flow regulation. Valve [10] Purpose of borchole (check one): Home (well will construction, skip the remainder of this block! <td>Driller: Fitzerald</td> <td></td> <td>Well #:</td>	Driller: Fitzerald		Well #:
(601)354-6938 (fax) Later Law requires that this report be prepared by the license holder responsible for the work and filed with the Department at the above address within 30 days of completion of drilling of the well or borehole. Unformation on Well Owner (Landowner if borehole is not for a water well) Owner Name Multhen, Ucalla the Mailing Address: Erm.f. Leuvl. Date drilling started. Erm.f. Leuvl. Used of Lat Long (circle one): Conventional Survey. USGS quad. Hand-held GPS, Survey-grade GPS Nat. State City Sec.Ho Make City Sec.Ho Make City Sec.Ho Make Well / Borehole Data Direction Mate of rilling started. EME of the output: Well / Borehole Data Makes Date drilling started. EME of the output: Name of organization running Botos: No log of the source of any surface water used for drilling: Mathed of flow regulation running Botos: No log output: Purpose of borehole (check one): Water Well Construction, skip the remainder of this block Purpose of Well (check one): HomeLondustrial Public Supply_ Irrigation_ Fish Culture Other: If a flowing well, method of		· ·	L. S. Elevation:
State Law requires that this report be prepared by the license holder responsible for the work and filed with the Department at the above address within 30 days of completion of drilling of the well or borehole. Information on Well Owner Information on Well Owner (Landomeri f) borehole is not for a water well) Well or Borehole Location Owner Name Multur Ucdla the Well or Borehole Location Mailing Address: Ernel Lawel Used articles Well or Borehole Location Latitude: 31 - 23 - 58 - Conjende-90 - 32 - 36 Mailing Address: Ernel Lawel Used art Long (circle one): Conventional Survey. USGS quad. Hand-held GPS, Survey-grade GPS Cuy of Log and Volume of Chlorine used for drilling: Method of Lat Long (circle an applicable Volume) Well / Borehole Data Date drilling started: 40 - 05 Location of the source of any surface water used for drilling: Method of dosing and volume of Chlorine used in drilling and development: Logs un (circle all applicable Volog run) Discertice and well. Maine or organization running bars Purpose of borehole (check one): Water Well Geotecchaical/Geological Investigation Ground Source Heat Pump	Date drilling completed: U 70-03		
Department at the above address within 30 days of completion of drilling of the well or borehole. Information on Well Owner (Landowner if borehole is not for a water well) Owner Name Multiple Mailing Address: Em. / Lawel: Well or Borehole Location Latude: 31. • 23. • 58. • Longitude: 40. • 32. • 36. Mailing Address: Em. / Lawel: Uses USGS quad. Hand-held GPS. Survey-grade GPS Nating Address: Em. / Lawel: USGS quad. Hand-held GPS. Survey-grade GPS Nie: Sitate Zip Code Neel / Borehole Data Date drilling started. Goog Chrlo Well / Borehole Data Method of dosing and volume of Chiorne used in drilling and development: Location of the source of any surface water used for drilling: Method of dosing and volume of Chiorne used in drilling and development: Logs run (circle all applicable No log run Electric Gamma Ray Density Sonic Neutron Other: Name of organization running log(st) Purpose of borchole (check one): Water Well / Geoetchnical Geological Investigation Grund Source Heat Pump	· · · · · · · · · · · · · · · · · · ·	(601)354-6938 (fax)	E-log #:
Information on Well Owner (Landowner if borchole is not for a water well) Owner Name Multiple Mailing Address: Ern f Luxel. Bays och ho MS Bays of bays of a water used for drilling: Miles Date drilling started. Bays of againzation running bays: Well of dosing and volume of Chionne used in drilling: Maile of againzation running bays: Purpose of borehole (check one): Water Well Lieotechnical Geological Investigation Ground Source Heat Pump			
(Landowner if borchole is not for a water well) Dwner Name Multicle U Mailing Address: Ern L Lauk! Borchole Data USGS quad. Hand-held GPS, Survey-grade GPS State Zip Code Well / Borchole Data Distance Date drilling started: GPO of Boochole Data Date drilling started: GPO of Doochole Data Date drilling started: Geological Investigation			
Dwner Name Multillag		or a water well)	
Mailing Address: Em.f. Lawel. Mailing Address: Em.f. Lawel. Bosech-lo_ms USGS quad. Hand-held GPS, Survey-grade GPS Network State Zip Code Well / Borehole Data Date drilling started. 200 Chrlo Well / Borehole Data Melod of Lat Long (circle one): Conventional Survey. Date drilling started. 200 Chrlo Well / Borehole Data Melod of doing and volume of Chlorine used for drilling: Method of doing and volume of Chlorine used in drilling and development: Hole diameter: Location of the source of any surface water used for drilling: Method of Chlorine used in drilling: Method of doing and volume of Chlorine used in drilling: Method of Melogen Other: Location of the source of any surface water used for drilling: Melod elevelopment: Logs run (circle all applicable) No log run Electric Gamma Ray Density Sonic Neutron Other: Name of organization running log(5): Statte Well / Geotechnical Geological Investigation		1	3 58 " Longitude: 90 • 32 · 36 "
USGS quad. Hand-held GPS, Survey-grade GPS City State Zip Code Telephone No. [] Well / Borehole Data Date drilling started: CHO S Date drilling completed: CHO - QE Hole depth: II6 Hole diameter: E'' Location of the source of any surface water used for drilling: Method of dosing and volume of Chlorine used in drilling and development: Location of the source of any surface water used for drilling: Method of dosing and volume of Chlorine used in drilling and development: Location of the source of any surface water used for drilling: Method of dosing and volume of Chlorine used in drilling and development: Logs run (circle all applicable) No log run Electric Gamma Ray Density Sonic Neutron Other: Name of organization running logter: Purpose of borchole (check one): Water Well Checetchnical Geological Investigation Ground Source Heat Pump Seismic Survey_Other (describe) If drilling is not related to water well construction , skip the remainder of this block Purpose of Well (check one): House L industrial Public Supply Irrigation Fish Culture Other: If a flowing well, method of flow regulation: ValveOther (describe) Static Water Level: electric tape air line other: Well depth: <u>IIO</u> well grouted to a depth of <u>IU</u> feet Type of grout (circle one): Neat Cement Befinonite Mix Casing length: <u>IO</u> feet Screen diameter: <u>Y''</u> inches Type of casing: <u>Mix</u> Screen slot size:	1		g (circle one): Conventional Survey,
City State Zip Code State Zip Code Distance Direction Niles Direction No	Mailing Address: ETN-[[Hand-held GPS, Survey-grade GPS
City State Zip Code State Zip Code Distance Direction Niles Direction No	$\overline{\rho}$		
Telephone No. ()	Dosoch-to M	15/	
Well / Borchole Data Well / Borchole Data Date drilling started: 2005 Date drilling completed: 670-05 Hole depth: 116 Hole diameter: 8''' Location of the source of any surface water used for drilling: Method of dosing and volume of Chlorine used in drilling and development: Location of the source of any surface water used for drilling: Method of dosing and volume of Chlorine used in drilling and development: Location of the source of any surface water used for drilling: Method of dosing and volume of Chlorine used in drilling and development:	City Sta	ate Zip Code Distance D	Direction Nearest Town
Well / Borchole Data Date drilling started: 6.20-05 Date drilling completed: 6.20-06 Hole depth: 11.6 Hole diameter: 6.11 Location of the source of any surface water used for drilling: Method of dosing and volume of Chlorine used in drilling and development: Logs run (circle all applicable) No log run Electric Gamma Ray Density Sonic Neutron Other: Name of organization running log(s): Detectric Gamma Ray Density Sonic Neutron Other: Purpose of borchole (check one): Water Well & Geotechnical/Geological Investigation Ground Source Heat Pump	Telephone No. ()	Miles	Viat or 10 OSCIUNTU
Date drilling started: <i>Date drilling completed: Date drilling completed: Date drilling:</i> Hole diameter: <i>Date drilling completed: Date drilling:</i> Hole diameter: <i>Description: Description: Descripti: Description: Description:</i>			
Method of dosing and volume of Chlorine used in drilling and development: Logs run (circle all applicable No log run Electric Gamma Ray Density Sonic Neutron Other: Name of organization running log(s) Purpose of borchole (check one): Water Well Geotechnical/Geological Investigation Ground Source Heat Pump Scismic SurveyOther (describe)	Date drilling started: 6-20-05 Date d		6 Hole diameter: 8''
Name of organization running log(s): Purpose of borehole (check one): Water Well Geotechnical/Geological Investigation Ground Source Heat Pump Seismic Survey Other (describe) If drilling is not related to water well construction, skip the remainder of this block Purpose of Well (check one): Home / Industrial Public Supply Irrigation Fish Culture Other: If a flowing well, method of flow regulation: Valve Other (describe)	Location of the source of any surface was Method of dosing and volume of Chlorin	ter used for drilling:	
Seismic Survey_Other (describe) If drilling is not related to water well construction, skip the remainder of this block Purpose of Well (check one): HomeL_Industrial_Public Supply_Irrigation_Fish Culture_Other: If a flowing well, method of flow regulation: ValveOther (describe) Static Water Level: 657 feet above or below (circle one) land surface Date measured: 6720-05 Method of Measurement (circle one) electric tape Well depth: 110 Well grouted to a depth of 10/0 feet Type of casing: 10/0 Screen length: 10/0 feet Screen diameter: Y" inches Screen slot size: 018 inches Setting depth: From 100 feet Screen slot size: 018 inches Setting depth: From 100 feet Screen slot size: 018 inches Setting depth: From 100 feet Screen slot size: 018 inches Setting depth: From 100 feet Screen slot size: 010	Logs run (circle all applicable) No log run Name of organization running log(s)	un Electric Gamma Ray Density Sonic 1	Neutron Other:
If drilling is not related to water well construction, skip the remainder of this block Purpose of Well (check one): Home industrial Public Supply Irrigation Fish Culture Other: If a flowing well, method of flow regulation: Valve Other (describe) Static Water Level: 6.20-05 Method of Measurement (circle one) steel tape electric tape air line well depth: 110 Well grouted to a depth of 10 feet Type of casing: 00 Screen length: 10' feet Setting depth: From Type of completion (circle all applicable): Gravel packed Underreamed Telescoped Open hole Natural Development	Purpose of borchole (check one): Water V	Well_LGeotechnical/Geological Investigation_	Ground Source Heat Pump
If drilling is not related to water well construction, skip the remainder of this block Purpose of Well (check one): Home industrial Public Supply Irrigation Fish Culture Other: If a flowing well, method of flow regulation: Valve Other (describe) Static Water Level: 6.20-05 Method of Measurement (circle one) steel tape electric tape air line well depth: 110 Well grouted to a depth of 10 feet Type of casing: 00 Screen length: 10' feet Setting depth: From Type of completion (circle all applicable): Gravel packed Underreamed Telescoped Open hole Natural Development	Seismic	Survey Other (<i>describe</i>)	-
If a flowing well, method of flow regulation: ValveOther (describe)			r of this block
Static Water Level: 45 feet above or below (circle one) land surface Date measured: 6720-05 Method of Measurement (circle one) (circle inclusted) electric tape air line other: Well depth: 110 ⁻ Well grouted to a depth of 10 ⁻ feet Type of grout (circle one): Neat Cement Bentonite Mix Casing length: 10 ⁻ feet Casing diameter: 9 ⁻¹¹ inches Type of casing: 9 ⁻¹² Screen length: 10 ⁻ feet Screen diameter: 9 ⁻¹¹ inches Type of screen: 10 ⁻ Screen slot size: 01 ² inches Setting depth: 100 ⁻ feet feet Type of completion (circle all applicable): Gravel packed Underreamed Telescoped Open hole Natural Development	Purpose of Well (check one): Home	Industrial Public Supply Irrigation Fi	sh Culture Other:
Static Water Level: <u>Los</u> feet above or below (circle one) land surface Date measured: <u>6</u> 20 - 05 Method of Measurement (circle one) (tell tape) electric tape air line other: Well depth: <u>110</u> Well grouted to a depth of <u>10</u> feet Type of grout (circle one): Neat Cement Bentonite Mix Casing length: <u>100</u> feet Casing diameter: <u>911</u> inches Type of casing: <u>010</u> Screen length: <u>100</u> feet Screen diameter: <u>911</u> inches Type of screen: <u>1107</u> Screen slot size: <u>018</u> inches Setting depth: From <u>100</u> feet feet Type of completion (circle all applicable): Gravel packed Underreamed Telescoped Open hole Natural Development		ion: Valve Other (describe)	
Method of Measurement (circle one) teel tape electric tape air line other:			A .
Casing length: 10c feet Casing diameter: 9/1 inches Type of casing: 9/c Screen length: 10' feet Screen diameter: 9'' inches Type of screen: 9/c Screen slot size: 013 inches Setting depth: From 100' feet to 110' feet Type of completion (circle all applicable): Gravel packed Underreamed Telescoped Open hole Natural Development			
Casing length: 10c ⁻ feet Casing diameter: 911 inches Type of casing: 912 Screen length: 10 ⁻ feet Screen diameter: 911 inches Type of screen: 912 Screen slot size: 013 inches Setting depth: From 100 ⁻ feet feet Type of completion (circle all applicable): Gravel packed Underreamed Telescoped Open hole Natural Development	Well depth: 110 Well grouted to a d		
Screen length: 0' feet Screen diameter: 4'' inches Type of screen: Ave Screen slot size: 013 inches Setting depth: From 100' feet to 110' feet Type of completion (circle all applicable): Gravel packed Underreamed Telescoped Open hole Natural Development			
Screen slot size:			
Type of completion (circle all applicable): Gravel packed Underreamed Telescoped Open hole Natural Development			
		\frown	
	A construction (construction applications		
Top of lap pipe or reduction in casing:feet. If telescoped or more than one screen, describe on next page	Top of lap pipe or reduction in casing:	feet. If telescoped or more the	an one screen, describe on next page
			RECEI

z

Э

ŗ

JUL 0 7 2005 BY: OLWR


The sketch below only required for water wells

If well telescopes, show depths on sketch. Ground Level_ 2

Description of formations encountered must be provided wells and boreholes, unless specifically exempted by regulations

Description of Formations Encountered	From (depth)	To (depth)
	Ground Level	
<u> </u>	Ó	20
Sandy loam,	20	60
sundallast	60	80
<u> </u>	80	90
Fire sand Curse Sand	90	100
Carte Sand	100	110
		1
		+
	_	
	-+	
		-

If more than one screen, show location of each on sketch

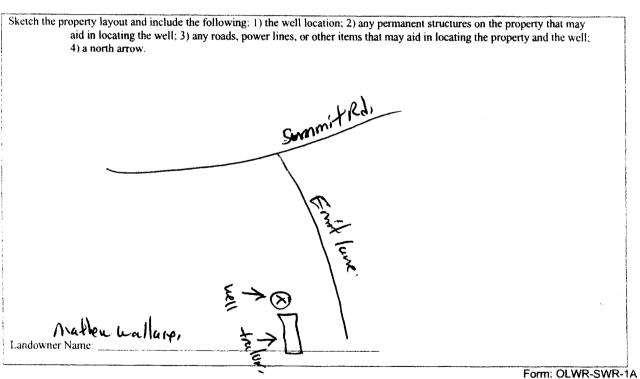

I certify that the well/borchole was drilled, constructed, and completed in accordance with all applicable requirements of the Mississippi Department of Environmental Quality and the Mississippi Department of Health regulations, if applicable, and state

6-20-05

BIAd F. tzyeruld

Brolg Signature of Licensee

Print Name of Responsible Licensee and License No.

Date

RECEIVED JUL 07 2005 BY: OLWR

_	STATE WI	ELL REPORT		
Driller: F. F. Zepra 11 Well Server Date completed: 6-20-05	Pump Installer Mississippi Departmen Office of Land P.O. Jackson, N (601	Part 2 (s Completion Report nt of Environmental Quality and Water Resources Box 10631 MS 39289-0631 (961-5210 MA 6938 (fax)	Aquifer: Well #:	e Use Only: - 73
Copy information from block on Part 1		54-6938 (fax)	L	
This part of the report must be completed by report must be attached and both parts filed	a licensed water well with the Department	contractor or a licensed pump in at the above address within 30 d	nstaller. A copy of avs of well complete	f Part 1 of the
Well Owner Informatio	n		l Location	
Owner Name: Muthen Walla	ypr	Latitude:	Longitude:	
Mailing Address: Emit lane	<u>.</u>	Method of Lat/Long (check or	-	
Bogoch-lu MS City State	Zip Code	USGS quad Hand-held ¼ ¼ Sec Distance Direction Miles	T <u>SN</u> R Nearest Tow	<u>7</u> n
Pump Type Circle one		1	wer Type ircle one	
Air Lift Jet	submersible	Diesel Engine Gasolir	ne Engine	Natural Gas
Bucket Piston	Furbine	Electric Motor Hand		Tractor PTO
Centrifugal Rotary	Flowing Well		(specify):	
Other (specify):		Horse Power Rating of Motor	12	1974 N.Y., Managaman an - 1979 North State (1974)
Date Pump Installed: 6-20-05		Setting Depth:95	<u> </u>	feet
Rated Pump Capacity:	iallons Per Minute	Number of Stages:		
Pump Test Data Date Well Tested:			easuring Water L.	evel
Static Water Level (A):Feet B Pumping Water Level (B):Feet B	elow Land Surface	Air Line Electric Mea Other (specify):	-	Steel Tape
Drawdown [(B) - (A)]:Feet B	elow Land Surface	For flowing well, measured st	hut in head:	feet
Test Pumping Rate:C	allons Per Minute	Well yielded	GPM with a dr	awdown of
Duration of Pump Test (minimum 4 hours):	hours	feet after	hoi	urs of pumping
1 HEREBY CERTIFY that the above stateme <u>Buod</u> F-1 <u>Score</u> 12 Print Name of Pump Installer and License No	074.	of my knowledge.		
				JUL 0 7 2005
	5			

•

• *

> 2005 JUL 0 7 2005 BY: OLWR