

State Well Report

Part 1 - Driller's Log

Mississippi Department of Environmental Quality
Office of Land and Water Resources
P.O. Box 10631
Jackson, MS 39289-0631
(601)961-5210
(601)354-6932 (fax)

For Office Use Only:

Acquirer:
Well #: P-83
L. S. Elevation:
E-log #:

County: Lincoln
Driller: Fitzgerald Well Service
Date drilling completed: 10-12-07

State Law requires that this report be prepared by the license holder responsible for the work and filed with the Department at the above address within 30 days of completion of drilling of the well or borehole.

Information on Well Owner (Landowner if borehole is not for a water well)
Owner Name: Frank Lobiz
Mailing Address: Homer Lane, Bogachto ms.
Well or Borehole Location
Latitude: 31.25.38 Longitude: 90.28.508
Method of Lat/Long (circle one): Conventional Survey
USGS quad, Hand-held GPS, Survey-grade GPS
NE 1/4 SE 1/4 Sec 3 Twn 5N Rng 7E
Distance Direction Nearest Town
Miles of


Well / Borehole Data
Date drilling started: 10-12-07 Date drilling completed: 10-12-07 Hole depth: 81' Hole diameter: 7"
Location of the source of any surface water used for drilling:
Method of dosing and volume of Chlorine used in drilling and development:
Logs run (circle all applicable): No log run Electric Gamma Ray Density Sonic Neutron Other:
Name of organization running log(s):
Purpose of borehole (check one): Water Well Geotechnical/Geological investigation Ground Source Heat Pump
Seismic Survey Other (describe):
If drilling is not related to water well construction, skip the remainder of this block
Purpose of Well (check one): Home Industrial Public Supply Irrigation Fish Culture Other:
If a flowing well, method of flow regulation: Valve Other (describe):
Static Water Level: 45 feet above or below (circle one) land surface Date measured: 10-12-07
Method of Measurement (circle one) steel tape electric tape air line other:
Well depth: 81 Well grouted to a depth of 10 feet Type of grout (circle one): Neat Cement Bentonite Mix
Casing length: 71 feet Casing diameter: 4 inches inches Type of casing: PVC
Screen length: 10 feet Screen diameter: 4 inches inches Type of screen: PVC
Screen slot size: .012 inches Setting depth: From 71 feet to 81 feet
Type of completion (circle all applicable): Gravel packed Underreamed Telescoped Open hole Natural Development
Other (describe):
Top of tap pipe or reduction in casing: feet. If telescoped or more than one screen, describe on next page

Form: OLWR-SWR-1A
RECEIVED
OCT 26 2007
BY: OLWR

clay	0	20
Sand	20	40
gravelly Sand	40	60
coarse Sand	60	70
	70	81

If more than one screen, show location of each on sketch

Sketch the property layout and include the following: 1) the well location; 2) any permanent structures on the property that may aid in locating the well; 3) any roads, power lines, or other items that may aid in locating the property and the well; 4) a north arrow.

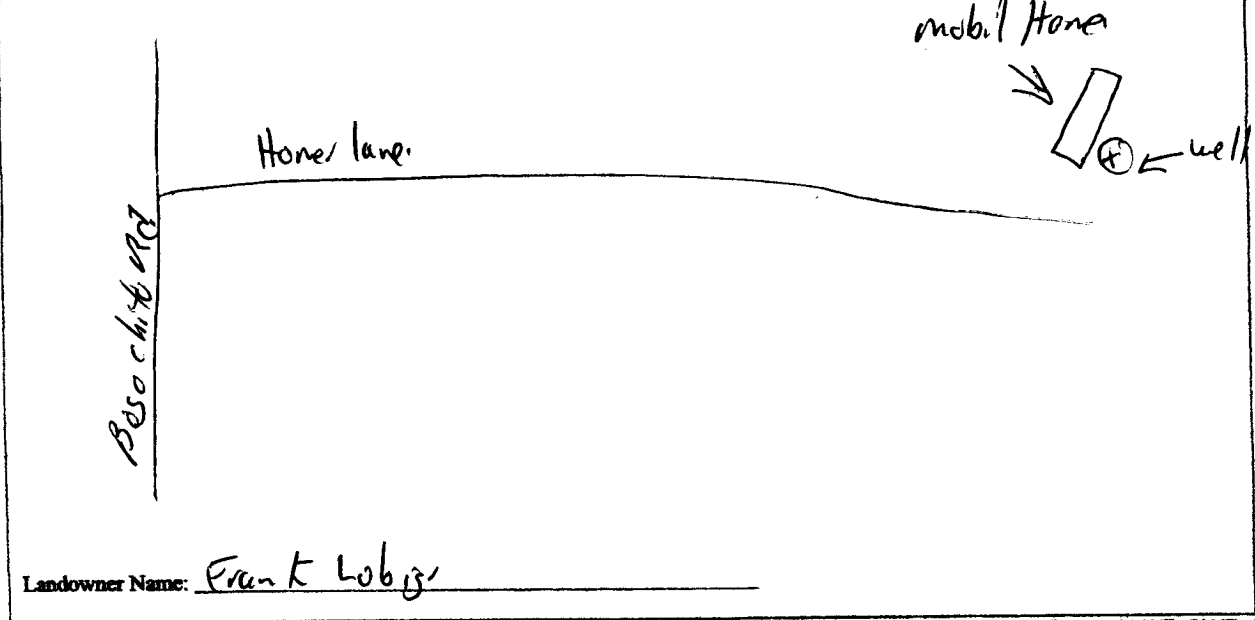

Landowner Name: Frank Lobis

Form: OLWR-SWR-1A

I certify that the well/borehole was drilled, constructed, and completed in accordance with all applicable requirements of the Mississippi Department of Environmental Quality and the Mississippi Department of Health regulations, if applicable, and state

laws: Brad Fitzgerald 029. 10-12-07 Paul Stapp

Print Name of Responsible Licensee and License No. Date Signature of Licensee

RECEIVED  
OCT 26 2007  
BY: OLWR

# STATE WELL REPORT

## Part 2

**Pump Installer's Completion Report**  
 Mississippi Department of Environmental Quality  
 Office of Land and Water Resources  
 P.O. Box 10631  
 Jackson, MS 39289-0631  
 (601)961-5210  
 (601)354-6938 (fax)

County: Lincoln  
 Permit #: \_\_\_\_\_  
 Driller: Fitzgerald Well Serv  
 Date completed: 10-12-07  
*Copy information from block on Part 1*

For Office Use Only:

Aquifer: \_\_\_\_\_  
 Well #: P-83  
 Elevation: \_\_\_\_\_

*This part of the report must be completed by a licensed water well contractor or a licensed pump installer. A copy of Part 1 of the report must be attached and both parts filed with the Department at the above address within 30 days of well completion.*

Well Owner Information	Well Location
Owner Name: <u>Frank Lobig</u>	Latitude: <u>31° 25' 38"</u> Longitude: <u>90° 28' 50.8"</u>
Mailing Address: <u>Home Ave.</u>	Method of Lat/Long (check one): Conventional Survey _____
<u>Bozochville</u>	USGS quad _____ Hand-held GPS _____ Survey-grade GPS _____
City _____ State _____ Zip Code _____	_____ ¼ _____ ¼ Sec _____ T. _____ R. _____
Telephone No. (____) _____	Distance _____ Direction _____ Nearest Town _____
	_____ Miles _____ of _____

Pump Type Circle one	Power Type Circle one
Air Lift      Jet <input checked="" type="radio"/> Submersible	Diesel Engine      Gasoline Engine      Natural Gas
Bucket      Piston      Turbine	<input checked="" type="radio"/> Electric Motor      Hand      Tractor PTO
Centrifugal      Rotary      Flowing Well	Windmill      Other (specify): _____
Other (specify): _____	Horse Power Rating of Motor: <u>1</u>
Date Pump Installed: <u>10-12-07</u>	Setting Depth: <u>75'</u> feet
Rated Pump Capacity: <u>20</u> Gallons Per Minute	Number of Stages: <u>8</u>

Pump Test Data	Method of Measurement: Water Level Circle one
Date Well Tested: _____	Air Line      Electric Measuring Line <input checked="" type="radio"/> Steel Tape
Static Water Level (A): _____ Feet Below Land Surface	Other (specify): _____
Pumping Water Level (B): _____ Feet Below Land Surface	For flowing well, measured shut in head: _____ feet
Drawdown [(B) - (A)]: _____ Feet Below Land Surface	Well yielded _____ GPM with a drawdown of _____
Test Pumping Rate: _____ Gallons Per Minute	_____ feet after _____ hours of pumping
Duration of Pump Test (minimum 4 hours): _____ hours	

I HEREBY CERTIFY that the above statements are true to the best of my knowledge.

Brad Fitzgerald      oreu  
 Print Name of Pump Installer and License No. (if applicable)

Brad Fitzgerald  
 Signature of Pump Installer

**RECEIVED**  
 OCT 26 2007  
 BY: OLWR