County: <u>Licoln-</u> Permit #: Driller: <u>Filzewald Will Jerura</u> Date drilling completed: <u>9-13-13</u>	P.O. DOX 2309	For Office Use Only: Well #: PIC4 Aquifer: E-Log #:
Date drilling completed: <u>9-13-13</u> ,	Jackson, MS 39225-2309 (601)961-5210 (601)360-0535 (fax)	E-Log #:

. . - 1

State Law requires that this report be prepared by the license holder responsible for the work and filed with the Department at the above address within 30 days of completion of drilling of the well or borehole.

Department at the above address within 50 days of con	Aprendit of uniting of the weat of borenoise			
Well Owner Information	Well or Borehole Location			
(Landowner if borehole is not for a water well)	Latitude: 31° 23'34.4 Longitude: 40° 28' 52.4"			
Owner Name: Ken Moak.	Method of Lat/Long ( <i>check one</i> ): Conventional Survey,			
Mailing Address: <u>Rig Creek Rd</u> ,				
	USGS quad, Hand-held GPS, Survey-grade GPS			
Bocochto ms	<u>NE 14 NE 14, Sec 22 T 5N R 7E</u>			
City State Zip Code	Miles of			
Telephone No. ()	(Distance) (Direction) (Nearest Town)			
Well / Borehole Data Date drilling started: <u>9-13-13</u> Date drilling completed: <u>9-13-13</u> . Hole depth: <u>95</u> Hole diameter: <u>8</u> "				
Location of the source of any surface water used for drilling	ng:			
Method of dosing and volume of Chlorine used in drilling a	nd development:			
Logs run (circle all applicable): Kolog run> Electric Gam	na Ray Density Sonic Neutron Other:			
Name of organization running log(s):	on running log(s):			
Purpose of borehole (circle one): Water Well Geotechni	ical/Geological Investigation Ground Source Heat Pump			
Seismic Survey Other (describe)				
	construction, skip the remainder of this block			
Purpose of Well (circle all applicable)  Home  Industrial  Public Supply  Irrigation  Fish Culture    Other (describe):				
			Static Water Level: <u>37</u> feet [above or below (circle one)	v] land surface Date measured: <u>9-13-13</u> ,
				tape Air line Other ( <i>describe</i> ):
	feet Type of grout (circle one): Neat Cemert Bentonite Mix			
	4" inches Type of casing: Puc			
	Y inches Type of screen: Puc			
Screen slot size:O(Oinches Setting depth				
Type of completion (circle all applicable): Gravel packed	Underreamed Open hole Natural Development RECEIVED			
Other (describe):	t saw a for the local to be and			
Top of lap pipe or reduction in casing:feet				
	one screen, describe on next page			

Form: OLWR-SWR-1A (4/13)

County: Licely	٦
Permit #:	

For Office Use Onl	y:	
--------------------	----	--

6

YJ SO

70

80

20

20

40 50

20


80

25

The sketch below only required for water wells

## If well telescopes, show depths on sketch.

Ground Level

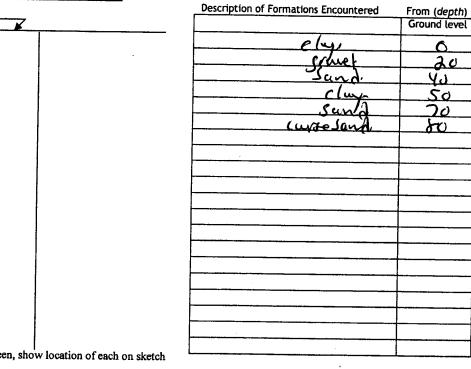

If more than one screen, show location of each on sketch

Sketch the property layout and include the following:	
1) the well location	
2) any permanent structures on the property that may aid in locating the well	
3) any roads, power lines, or other items that may aid in locating the property and the well	
4) north arrow	
Aug	
Dis Creek Rd.	
Big Creek Rd.	
Hellmouth Rd	
A A A A A A A A A A A A A A A A A A A	
31	
all in the second se	4 2
MT Plesant	
- resamp	
Huy SI	
1	
Landowner Name: Ken Moat	
I HEREBY CERTIFY that the well/borehole was drilled, constructed, and completed in accord	ance with all applicable
requirements of the Missission Dendi (ment of Environmental Duality and the Mississioni Dee	partment of Health regulations
if applicable, and state laws.	an emerie of meatern regulations,
BIAd Elzaeld. 079. 9-18-12 Belth	,
Frint Name of Responsible Licensee and License No. Date Signa	ture of Licensee
•	Form: OLWR-SWR-1A (4/13)

<u>Description of formations encountered must be provided for all wells</u> and boreholes, unless specifically exempted by regulations From (depth) To (depth)

L - . .

1			
STATE `	WELL REPORT		
County: Lite M	Part 2 For Office Use Only:		
	Iller's Completion Report artment of Environmental Quality   Well #:P104		
Driller: vitzevila Will Alve Office of	Land and Water Resources		
Date completed: <u>9-13-13-</u>	P.O. Box 2309 kson, MS 39225-2309 Aquifer:		
Copy information from block on Part 1	(601)961-5210		
(6	501) 360-0535 (fax)		
	tter well contractor or a licensed pump installer. A copy of Part 1		
of the report must be attached and both parts filed with the Department at the above address within 30 days of well completion.      Well Owner Information    Well Location			
Owner Name: Ken Moat.			
Mailing Address: Bry Creek. Rd.	Hothed of Lat /Long (check are), Conventional Supray		
Mailing Address: <u>IV 9 (188A: 188</u>			
	USGS quad, Hand-held GPS, Survey-grade GPS		
Bogue Chils MJ City State Zip Code	¼¼, Sec T R		
Telephone No. ()	(Distance) (Direction) of (Nearest Town)		
	Type (circle one)		
	Il Jet Piston Rotary Other (describe):		
Date Pump Installed: <u>9-13-13</u> ,	Rated Pump Capacity:Gallons Per Minute		
Is This Pump (circle one): New Repaired Replacen			
	Type (circle one)		
Pleether Diesel Gasoline Natural Gas Tractor PTO V			
Horse Power Rating of Motor: Setting De	epth:feet Number of Stages:		
Pump Test Da	ta for Non Flowing Well		
Date Well Tested:	Duration of Pump Test (minimum 4 hours): hours		
Static Water Level (A): Feet Below Land Surfa	ace Pumping Water Level (B):Feet Below Land Surface		
Drawdown [(B) - (A)]:Feet Below Land S	Surface Test Pumping Rate:Gallons Per Minute		
Method of measurement (circle one): Steel tape Electric	c tape Air line Other ( <i>describe</i> ):		
	Data for Flowing Well		
Measured shut in head:feet.			
Well yieldedGPM with a drawdown of	feet afterhours of pumping		
Mete	er Installation		
	Meter Serial Number:		
	Type of Meter:		
	gal x 1000, etc):		
Installation Date: Meter installed by			
Is This Meter (circle one): New Repaired Replace			
Important: By submitting the above information you are For agricultural wells, a list of	e certifying that this meter was installed to manufacturer <b>signdards</b> . approved meters is on the MDEQ website.		
I HEREBY CERTIFY that the above statements are true to	the best of my knowledge.		
hat the it was given plitted			
BIAL F-Izuald. Print Name of Pump Installer and License No. (if applicab	Dee) 9-13-12 Buller		
	Form: OLWR-SWR-1B (4/13)		

•