

Lincoln
P 200
9-10-75

MISSISSIPPI
 BOARD OF WATER COMMISSIONERS
 416 North State Street
 Jackson, Mississippi 39201

WATER WELL DRILLERS LOG


Sept. 10 19 75 Grenn Water Well Lincoln
 date well completed firm name county well located

LANDOWNER:	description of formations encountered	from	to
Steve Sadser Route 3 Bogue Chitto, Miss. (mailing address)	Citronelle	0	145
WELL LOCATION:			
sec. <u>28</u> T. <u>5</u> N. R. <u>7</u> E. ¹³⁴			
<u>5</u> miles SW of Bogue Chitto (distance) (direction) (nearest town)			
WELL PURPOSE: home (home, irrigation, municipal, industrial).			
WELL COMPLETION DATA:			
(1) diameter (inches) <u>6"</u>			
(2) total depth (feet) <u>145</u>			
(3) static water level (feet) <u>60</u> below top of ground. above.			
(4) casing <u>XPvc</u> <u>139</u> (material) (depth) <u>4"</u> (size) if telescope see back.			
(5) screen <u>6'</u> <u>139</u> (length) (depth to top) <u>.010</u> <u>PVC</u> (size) (material)			
(6) pump <u>1/3</u> Sub <u>7</u> (HP) (yield gpm) <u>electric</u> (type power)			
(7) electric log <u>no</u> (yes or no) (organization running log)			
(8) how well bottom plugged <u>wood</u>			
DRILLERS REMARKS:			

MISSISSIPPI BOARD OF WATER COMMISSIONERS
 1975

If well telescopes please
sketch and show depths.

GROUND LEVEL

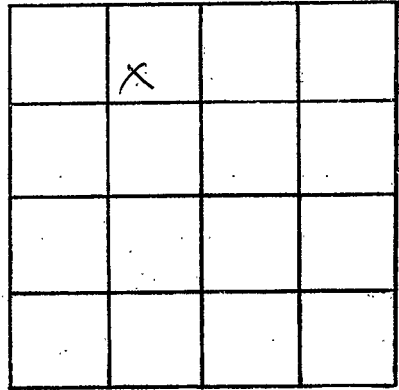

SECTION 28

Please indicate well location X.

ADDITIONAL INFORMATION

Lined area for additional information.

If more than one screen,
show locations of each on sketch.