

LINCOLN
 P 2001
 1-23-76

MISSISSIPPI
 BOARD OF WATER COMMISSIONERS
 416 North State Street
 Jackson, Mississippi 39201

WATER WELL DRILLERS LOG

29 Jan
 date well completed

132
 36

~~James H. Langston~~ *Langston*
 firm name

county well located

LANDOWNER:

Homer Wallard

Bayle Chitto
 (mailing address)

description of formations encountered

from

to

<i>Clay</i>	<i>0</i>	<i>70</i>
<i>Red chert sand</i>	<i>70</i>	<i>60</i>
<i>Sand</i>	<i>60</i>	<i>65</i>
<i>Sand</i>	<i>65</i>	<i>122</i>

WELL LOCATION:

sec. *19* T. *5* N. R. *7* E.

8 miles *NW* of *Sumit*
 (distance) (direction) (nearest town)

WELL PURPOSE:

(home, irrigation, municipal, industrial)

WELL COMPLETION DATA:

- (1) diameter (inches) *4*
- (2) total depth (feet) *122*
- (3) static water level (feet) *65* below top of ground.

(4) casing *pl* (material) *116* (depth)

(size) if telescope see back.

(5) screen *6* (length) *100* (depth to top)

4 (size) *pl* (material)

(6) pump *6* (HP) *8* (yield gpm)


chut (type power)

(7) electric log (yes or no)

(organization running log)

(8) how well bottom plugged *wood*


DRILLERS REMARKS:

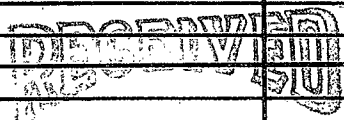

MAR 26 1976

If well telescopes please sketch and show depths.

GROUND LEVEL

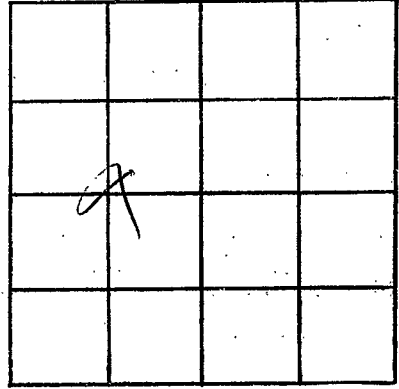

SECTION 19

Please indicate well location X.

ADDITIONAL INFORMATION

If more than one screen, show locations of each on sketch.