

Lincoln
P 2002
5/26/76

MISSISSIPPI
BOARD OF WATER COMMISSIONERS
416 North State Street
Jackson, Mississippi 39201

WATER WELL DRILLERS LOG

May 26 1976 *Recess Well Services* *Lincoln*
date well completed firm name county well located

LANDOWNER:
Jerry Barbett
Rt 3 Bonaichitto
(mailing address)

| description of formations encountered | from | to |
|---------------------------------------|-------------|-----------|
| | <i>clay</i> | <i>0</i> |
| <i>soft gravel</i> | <i>16</i> | <i>22</i> |
| <i>chalky sand</i> | <i>22</i> | <i>50</i> |
| <i>coarse sand</i> | <i>50</i> | <i>59</i> |

WELL LOCATION:
sec. 15 T 5 N R 7 E
3 miles well of Northfield
(distance) (direction) (nearest town)

WELL PURPOSE: home
(home, irrigation, municipal, industrial)

WELL COMPLETION DATA:

(1) diameter (inches) 4"

(2) total depth (feet) 59

(3) static water level (feet) 15 below above top of ground.

(4) casing plastic bottom
(material) (depth)

(size) If telescope see back.

(5) screen 4' 53
(length) (depth to top)

4" plastic
(size) (material)

(6) pump hercules
(HP) (yield gpm)

elect
(type power)

(7) electric log no
(yes or no)

(organization running log)

(8) how well bottom plugged?
wooden plug

DRILLERS REMARKS:
no remarks


RECEIVED

AUG 20 1976

MISS. BD. OF WATER COMMISSIONERS

If well telescopes please sketch and show depths.

GROUND LEVEL

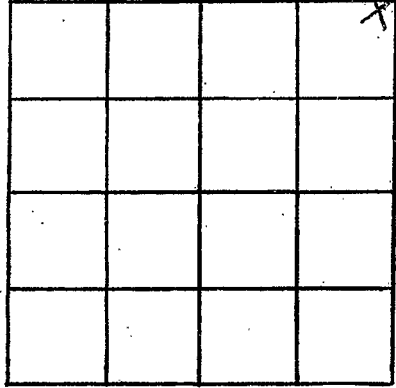

SECTION 15

Please indicate well location X.

ADDITIONAL INFORMATION

If more than one screen,
show locations of each on sketch.