

Lincoln
 P 2003
 5/28/76

MISSISSIPPI
 BOARD OF WATER COMMISSIONERS
 416 North State Street
 134 Jackson, Mississippi 39201

WATER WELL DRILLERS LOG

May 28 1976 Pearson Well Co Lincoln
 date well completed firm name county well located

LANDOWNER:
Preston Landry
Rt 3 - Bouschitto
 (mailing address)

description of formations encountered	from	to
<u>Clay</u>	<u>0</u>	<u>17</u>
<u>Red Chalky Sand</u>	<u>17</u>	<u>80</u>
<u>Peziand sand</u>	<u>80</u>	<u>97</u>

WELL LOCATION:
 sec 34 T 5 N R 7 E
3 1/2 miles S SW of Merfield
 (distance) (direction) (nearest town)

WELL PURPOSE: Tractor
 (home, irrigation, municipal, industrial)

- WELL COMPLETION DATA:
- diameter (inches) 4"
 - total depth (feet) 97
 - static water level (feet) 45 below top of ground
 - casing plastic bottom
 (material) (depth)
 (size) If telescope see back.
 - screen 6' 91'
 (length) (depth to top)
4" plastic
 (size) (material)
 - pump 1/2 1.0
 (HP) (yield gpm)
elect
 (type power)
 - electric log NO
 (yes or no)
 (organization running log)

(8) how well bottom plugged
Washed plug

DRILLERS REMARKS:
no remark


RECEIVED

AUG 20 1976

MISS. BD. OF WATER COMMISSIONERS

If well telescopes please sketch and show depths.

GROUND LEVEL

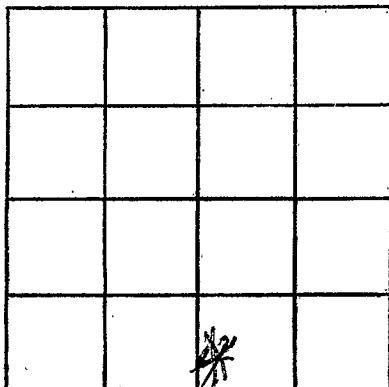

SECTION 34

Please indicate well location X.

ADDITIONAL INFORMATION

If more than one screen,
show locations of each on sketch.