

Lincoln  
 P 2004  
 8/4/76

MISSISSIPPI  
 BOARD OF WATER COMMISSIONERS  
 416 North State Street  
 Jackson, Mississippi 39201

WATER WELL DRILLERS LOG

1306  
 H. R. P. 1976 J. T. Cantor Lincoln  
 date well completed firm name county well located

LANDOWNER:	description of formations encountered	from	to
Emell Brumfield			
B. C. Mize (mailing address)	clay clay sand sand	0	70 70 35 74
<b>WELL LOCATION:</b> sec <u>23</u> T <u>5</u> N R <u>7</u> E <u>7</u> <u>3</u> <u>SE</u> (distance) miles (direction) of (nearest town) Booneville Summit			
<b>WELL PURPOSE:</b> (home, irrigation, municipal, industrial)			
<b>WELL COMPLETION DATA:</b> (1) diameter (inches) <u>4</u> (2) total depth (feet) <u>74</u> (3) static water level (feet) <u>55</u> below top of ground. (4) casing <u>pl</u> ( <u>63</u> ) (material) (depth) (size) if telescope see back. (5) screen <u>6</u> ( <u>68</u> ) (length) (depth to top) <u>4</u> ( <u>pl</u> ) (size) (material) (6) pump <u>1/2</u> ( <u>800</u> ) (HP) (yield gpm) <u>elect</u> (type power) (7) electric log <u>yes or no</u> (organization running log) (8) how well bottom plugged <u>wood</u>			
<b>DRILLERS REMARKS:</b>			


RECEIVED

OCT 20 1976

MISS. BD. OF WATER COMMISSIONERS

If well telescopes please sketch and show depths.

GROUND LEVEL

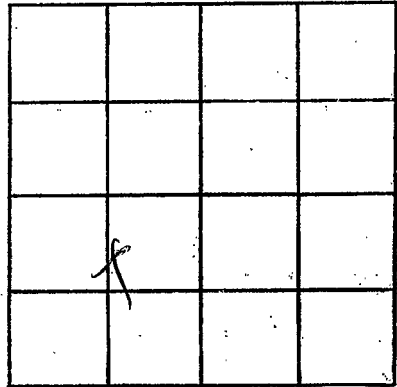

SECTION 23

Please indicate well location X.

ADDITIONAL INFORMATION

If more than one screen, show locations of each on sketch.