

Lincoln
P 2005
11/2/76

MISSISSIPPI
BOARD OF WATER COMMISSIONERS
416 North State Street
134 Jackson, Mississippi 39201

WATER WELL DRILLERS LOG

Nov 12 1976 Reuss Well Co Lincoln
date well completed firm name county well located

LANDOWNER:
George Latt
P.O. Summit
(mailing address)

description of formations encountered	from	to
clay	0	10
fine sand	10	55
well gravel sand	55	65

WELL LOCATION:
sec. 29 T-5 N R-7 E
5 miles N-NW of Summit
(distance) (direction) (nearest town)

WELL PURPOSE: private
(home, irrigation, municipal, industrial)

- WELL COMPLETION DATA:
- (1) diameter (inches) 4"
 - (2) total depth (feet) 65
 - (3) static water level (feet) 35 below above top of ground.
 - (4) casing plastic, bottom
(material) (depth)
 - if telescope see back.
(size)
 - (5) screen 6", 59'
(length) (depth to top)
 - 4", plastic
(size) (material)
 - (6) pump well other
(type) (yield gpm)
 - elect
(type power)
 - (7) electric log no
(yes or no)
 - (organization running log)

(8) how well bottom plugged
wooden plug


DRILLERS REMARKS:

RECEIVED
FFB - 7 1977

MISS. BD. OF WATER COMMISSIONERS

If well telescopes please sketch and show depths.

GROUND LEVEL

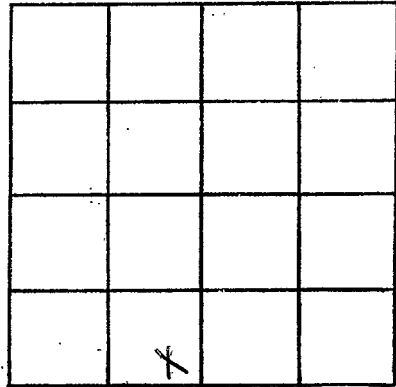

SECTION 27

Please indicate well location X.

ADDITIONAL INFORMATION

If more than one screen, show locations of each on sketch.