

Lincoln
P 2006
12/16/76

MISSISSIPPI
 BOARD OF WATER COMMISSIONERS
 416 North State Street
 Jackson, Mississippi 39201

WATER WELL DRILLERS LOG

12-16 1976 Grenn Water Well Contractor Lincoln
 date well completed firm name county well located

LANDOWNER:	description of formations encountered	from	to
Gary Davis			
Bogue Chitto, Miss. (mailing address)			
WELL LOCATION:			
sec. <u>2</u> T. <u>5</u> (N) R. <u>7</u> (E)			
<u>1</u> miles SW of Bogue Chitto			
(distance) (direction) (nearest town)			
WELL PURPOSE: <u>home</u> (home, irrigation, municipal, industrial)			
WELL COMPLETION DATA:			
(1) diameter (inches) <u>6</u>			
(2) total depth (feet) <u>82</u>			
(3) static water level (feet) <u>61</u> below top of ground.			
(4) casing <u>PVC</u> , <u>76°</u> (material) (depth)			
<u>4"</u> (size) If telescope see back.			
(5) screen <u>6°</u> , <u>76°</u> (length) (depth to top)			
<u>.010</u> , <u>76°</u> (size) (material)			
(6) pump <u>1/2 Sub.</u> <u>10</u> (HP) (yield gpm)			
<u>electricity</u> (type power)			
(7) electric log <u>no</u> (yes or no)			
(organization running log)			
(8) how well bottom plugged <u>back wash valve</u>			
DRILLERS REMARKS:			


RECEIVED

JAN 24 1977

MISS. BD. OF WATER COMMISSIONERS

If well telescopes please sketch and show depths.

GROUND LEVEL

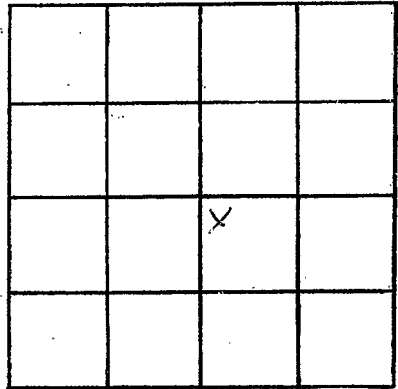

SECTION 2

Please indicate well location X.

ADDITIONAL INFORMATION

If more than one screen, show locations of each on sketch.