

Lincoln
 P 2007
 1-13-77

MISSISSIPPI
 BOARD OF WATER COMMISSIONERS
 416 North State Street
 Jackson, Mississippi 39201

WATER WELL DRILLERS LOG


13 Jan 1977 J. L. Corcoran & Son Lincoln
 date well completed firm name county well located

LANDOWNER:	description of formations encountered	from	to
Dorothy Acuntho Eugene Chitto (mailing address)			
WELL LOCATION:			
sec. 22 T. 5 N R. 7 E 3 miles S of B.C. (distance) (direction) (nearest town)			
WELL PURPOSE: (home, irrigation, municipal, industrial)			
WELL COMPLETION DATA:			
(1) diameter (inches) 4			
(2) total depth (feet) 94			
(3) static water level (feet) 75 above top of ground.			
(4) casing (material) P (depth) 88 (size) If telescope see back.			
(5) screen (length) 6 (depth to top) 88 (size) 4 (material) P			
(6) pump (HP) 1/2 (yield gpm) 8 (type power) electric			
(7) electric log (yes or no)			
(organization running log)			
(8) how well bottom plugged <i>crushed</i>			
DRILLERS REMARKS:			

RECEIVED
 FEB 14 1977
 MISS. BD. OF WATER COMMISSIONERS

If well telescopes please sketch and show depths.

GROUND LEVEL

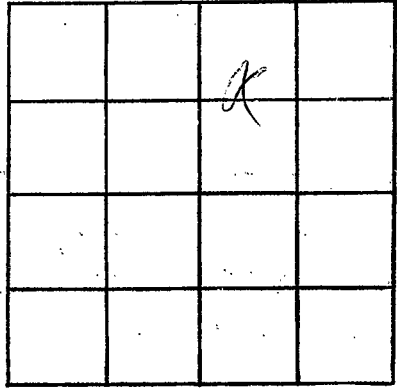

SECTION 22

Please indicate well location X.

ADDITIONAL INFORMATION

If more than one screen, show locations of each on sketch.