

Lincoln
 P 2009
 8/15/17

MISSISSIPPI
 BOARD OF WATER COMMISSIONERS
 416 North State Street
 Jackson, Mississippi 39201

WATER WELL DRILLERS LOG

Aug. 15 1917 Burnfield Well, South Lincoln
 date well completed firm name county well located

LANDOWNER: Philip MORA
PO # 3
Boque Chitto ms
 (mailing address)

description of formations encountered	from	to
Clay	0	21
SANDY CLAY	21	36
CHALK	36	50
SAND	50	58
SAND + Muck	58	70

WELL LOCATION:
 sec. 7 T 50 N R 7 E
6 miles W of B.C.
 (distance) (direction) (nearest town)

WELL PURPOSE: same
 (home, irrigation, municipal, industrial)

WELL COMPLETION DATA:

(1) diameter (inches) 4

(2) total depth (feet) 70

(3) static water level (feet) 52 below above top of ground.

(4) casing Plastic, 60
 (material) (depth)
4 if telescope see back.
 (size)

(5) screen 10 60
 (length) (depth to top)
4 Plastic
 (size) (material)

(6) pump 1/2 8
 (HP) (yield gpm)

(type power)

(7) electric log
 (yes or no)

(organization running log)

(8) how well bottom plugged wood


DRILLERS REMARKS:

RECEIVED
 NOV - 2 1917

MISS. BD. OF WATER JMM

If well telescopes please sketch and show depths.

GROUND LEVEL

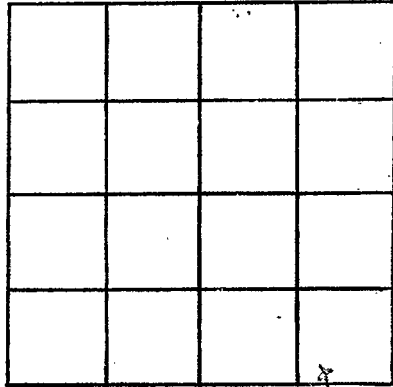

SECTION 1

Please indicate well location X.

ADDITIONAL INFORMATION

If more than one screen, show locations of each on sketch.