

Linsden
P 2010
8/23/77

MISSISSIPPI
BOARD OF WATER COMMISSIONERS
416 North State Street
Jackson, Mississippi 39201

WATER WELL DRILLERS LOG

Aug. 23 1977 date well completed
Barnfield Water Service Inc. firm name
Sommit county well located

LANDOWNER: Joe Winston
Sommit Miss.
(mailing address)
WELL LOCATION:
sec. 26 T 5 N R 2 E
11 miles N of Sommit
(distance) (direction) (nearest town)

description of formations encountered	from	to
CITY	0	26
CHALK	26	70
CHALK & SAND	70	88
SAND & GRACK	88	101

WELL PURPOSE: Home
(home, irrigation, municipal, industrial)

- WELL COMPLETION DATA:
- (1) diameter (inches) 4
 - (2) total depth (feet) 100
 - (3) static water level (feet) 84 below top of ground.
 - (4) casing PLASTIC 90 (material) (depth)
4 (size) if telescope see back.
 - (5) screen 10 90 (length) (depth to top)
4 (size) PLASTIC (material)
 - (6) pump 1/2 8 (HP) (yield gpm)
(type power)
 - (7) electric log (yes or no)
(organization running log)
 - (8) how well bottom plugged Wood


DRILLERS REMARKS:

RECEIVED
NOV - 2 - 1977

MISS. BD. OF WATER COMMISSIONERS

If well telescopes please sketch and show depths.

GROUND LEVEL

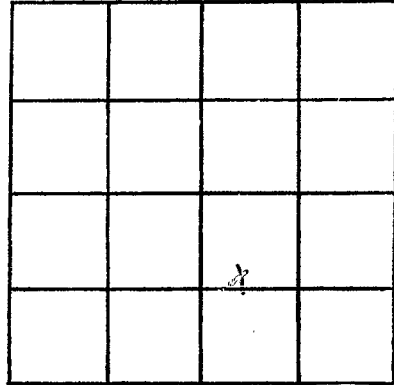

SECTION 26

Please indicate well location X.

ADDITIONAL INFORMATION

If more than one screen,
show locations of each on sketch.