

Lincoln
 P 2011
 8/24/77

MISSISSIPPI
 BOARD OF WATER COMMISSIONERS
 416 North State Street
 Jackson, Mississippi 39201

WATER WELL DRILLERS LOG

Aug. 20 77 19 Brunfield Well Sewer Lincoln
 date well completed firm name county well located

LANDOWNER: MEMPHIS CHURCH
Boque Chitto
MISS
 (mailing address)

WELL LOCATION:
 sec. 23 T 5 N R. 2 E
1 miles S of R.C.
 (distance) (direction) (nearest town)

WELL PURPOSE: Home
 (home, irrigation, municipal, industrial)

WELL COMPLETION DATA:
 (1) diameter (inches) 4
 (2) total depth (feet) 75
 (3) static water level (feet) 38 below above top of ground.
 (4) casing PLASTIC 65
 (material) (depth)
4 if telescope see back.
 (size)
 (5) screen 10 65
 (length) (depth to top)
4 PLASTIC
 (size) (material)
 (6) pump 1/2 4
 (HP) (yield gpm)
 (type power)
 (7) electric log
 (yes or no)
 (organization running log)
 (8) how well bottom plugged Wood

description of formations encountered	from	to
Clay	0	12
Clay Laminar	12	20
SAND + ROCK	20	33
CHALK	33	38
SAND	38	60
SAND + ROCK	60	75


DRILLERS REMARKS:

RECEIVED
 NOV - 2 1977

MISS. BD. OF WATER CONTROL

If well telescopes please sketch and show depths.

GROUND LEVEL

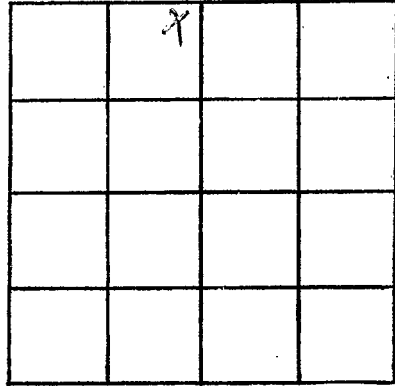

SECTION 23

Please indicate well location X.

ADDITIONAL INFORMATION

If more than one screen, show locations of each on sketch.