

Lincoln
 P 2012
 9/12/77

MISSISSIPPI
 BOARD OF WATER COMMISSIONERS
 416 North State Street
 Jackson, Mississippi 39201

WATER WELL DRILLERS LOG

Sept. 13 1977 Bromfield Well Serv. Lincoln
 date well completed firm name county well located

LANDOWNER: Eddie Brown
Rt. #3
Boque, Chitico Ms.
 (mailing address)

description of formations encountered	from	to
<u>CLAY</u>	<u>0</u>	<u>15</u>
<u>CLAY GRAVEL</u>	<u>15</u>	<u>28</u>
<u>CHARLES</u>	<u>28</u>	<u>30</u>
<u>SAND & GRK</u>	<u>30</u>	<u>50</u>

WELL LOCATION:
 sec. 28 T. 5 N. R. 7 E.
1 1/2 miles SSW. of B.C.
 (distance) (direction) (nearest town)

WELL PURPOSE: HOME
 (home, irrigation, municipal, industrial)

- WELL COMPLETION DATA:
- diameter (inches) 4
 - total depth (feet) 50
 - static water level (feet) 30 below top of ground
 - casing PLASTIC 40'
 (material) (depth)
4 if telescope see back.
 (size)
 - screen 10' 40'
 (length) (depth to top)
4 PLASTIC
 (size) (material)
 - pump 1/2 8
 (HP) (yield gpm)
 (type power)
 - electric log ns
 (yes or no)
 (organization running log)
 - how well bottom plugged Wood


DRILLERS REMARKS:

RECEIVED
 NOV 17 1977

MISS. BD. OF WATER COMM.

If well telescopes please sketch and show depths.

GROUND LEVEL

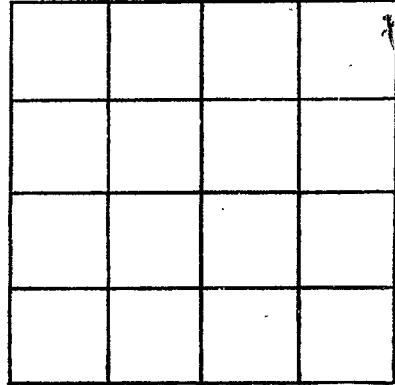

SECTION 28

Please indicate well location X.

ADDITIONAL INFORMATION

If more than one screen, show locations of each on sketch.