

LINCOLN
P 2013
2/28/78

MISSISSIPPI
BOARD OF WATER COMMISSIONERS
416 North State Street
Jackson, Mississippi 39201

WATER WELL DRILLERS LOG

Feb. 28 1978 Bromfield Well Serv. Lincoln
date well completed firm name county well located

LANDOWNER: Harlan Hodges
Pl. # 3
Boque Chitto Ms.
(mailing address)

description of formations encountered	from	to
SANDY CLAY	0	12
CLAY	12	38
SAND & GRAVEL	38	50
CHALK	50	61
SAND & ROCK	61	76

WELL LOCATION:
sec. 28 T. 5 N R. 7 E
8 miles N.W. of Summit
(distance) (direction) (nearest town)

WELL PURPOSE: Home
(home, irrigation, municipal, industrial)

- WELL COMPLETION DATA:
- (1) diameter (inches) 4
 - (2) total depth (feet) 76
 - (3) static water level (feet) 62 below above top of ground.
 - (4) casing Plastic 66
(material) (depth)
4 if telescope see back.
(size)
 - (5) screen 10' 66
(length) (depth to top)
4 Plastic
(size) (material)
 - (6) pump 1/2 7
(HP) (yield gpm)
electric
(type power)
 - (7) electric log No
(yes or no)


(organization running log)
(8) how well bottom plugged Sands/HAM

DRILLER'S REMARKS:

RECEIVED
MAR 21 1978

If well telescopes please sketch and show depths.

GROUND LEVEL

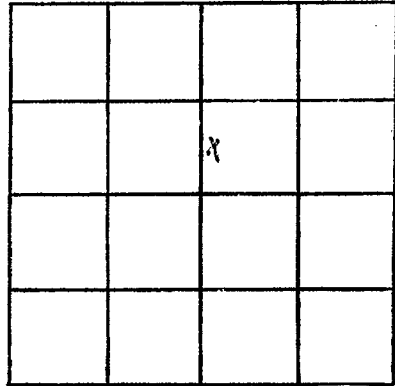

SECTION 28

Please indicate well location X.

ADDITIONAL INFORMATION

If more than one screen,
show locations of each on sketch.