

LINCOLN
 P 2015
 3/31/78

MISSISSIPPI
 BOARD OF WATER COMMISSIONERS
 476 North State Street
 Jackson, Mississippi 39201

WATER WELL DRILLERS LOG


March 31 1978 Grenn Water Well Cont. Lincoln
 date well completed firm name county well located

LANDOWNER:	description of formations encountered	from	to
Millard Moak Route 4	Citronelle	1	150
Bogue Chitto, Miss. (mailing address)			
WELL LOCATION: sec. 27 T 5 N R 7 E 6 miles S of Bogue Chitto (distance) (direction) (nearest town)			
WELL PURPOSE: home (home, irrigation, municipal, industrial)			
WELL COMPLETION DATA: (1) diameter (inches) 6 (2) total depth (feet) 150 (3) static water level (feet) 75 below top of ground. (4) casing PVC 144 (material) (depth) 4" (size) If telescope see back. (5) screen 6' 144' (length) (depth to top) .010 PVC (size) (material) (6) pump 3/4 HP Sub 10 (HP) (yield gpm) electricity (type power) (7) electric log no (yes or no) (organization running log) (8) how well bottom plugged back wash valve			
DRILLERS REMARKS:			

RECEIVED
 APR 17 1978
 MISS. BD. OF WATER COMMA

If well telescopes please sketch and show depths.

GROUND LEVEL

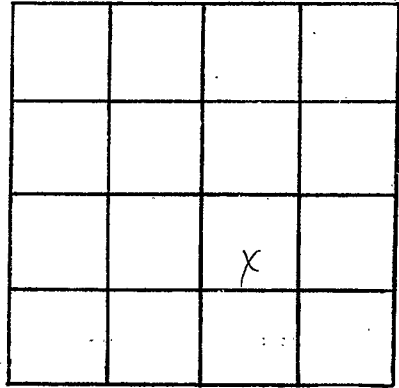

SECTION 27

Please indicate well location X.

ADDITIONAL INFORMATION

If more than one screen, show locations of each on sketch.