

BOARD OF WATER COMMISSIONERS
416 North State Street
Jackson, Mississippi 39201

LINCOLN

P 2016

02-10-79

WATER WELL DRILLERS LOG

Lincoln
Boyer

Feb 10 1979

Boyer Drillers

Lincoln

date well completed

firm name

county well located

LANDOWNER:

John S. Young -
811 New St - (mailing address)

description of formations encountered

from

to

Clay
artificial sand
sand gravel

0

12

12

24

54

58

WELL LOCATION:

sec. 33 T 5 N R 7 E
S
7 miles north of Summit
(distance) (direction) (nearest town)

WELL PURPOSE: *Trailer Camp*
(home, irrigation, municipal, industrial)

WELL COMPLETION DATA:

- (1) diameter (inches) 4"
- (2) total depth (feet) ~~42~~ - 58'
- (3) static water level (feet) 10 below top of ground.
- (4) casing plastic bottom
(material) (depth)
- ✓ if telescope see back.
(size)
- (5) screen 5' 9 7'
(length) (depth to top)
- 4" plastic
(size) (material)
- (6) pump Sub 10
(HP) (yield gpm)
- 1/2 HP
(type power)
- (7) electric log no
(yes or no)

(organization running log)

Miss. Board of Water Comm.

(8) how well bottom plugged
Wooden plug


DRILLERS REMARKS:

APR 26 1979

RECEIVED

If well telescopes please sketch and show depths.

GROUND LEVEL

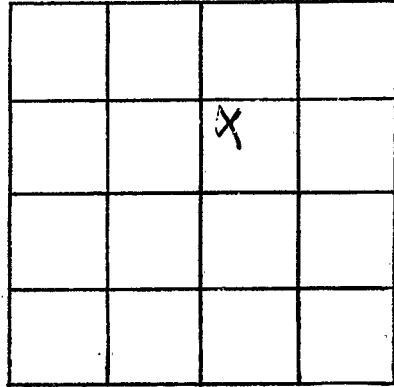

SECTION 33

Please indicate well location X.

ADDITIONAL INFORMATION

If more than one screen, show locations of each on sketch.