

Lincoln
P
2011
2-12-79

MISSISSIPPI
BOARD OF WATER COMMISSIONERS
416 North State Street
Jackson, Mississippi 39201

WATER WELL DRILLERS LOG

2-12
date well completed

19 79

Fleming Well Serv
firm name

Lincoln
county well located

LANDOWNER:

Lloyd Harmon

R.R. Summit, Mo.
(mailing address)

description of formations encountered

from

to

Red clay	0	20
Red sand	20	50
Coarse sandstone	50	68

WELL LOCATION:

sec. 29 T. 5 N. R. 7 E
7 miles NNW of Summit
(distance) (direction) (nearest town)

WELL PURPOSE:

(home, irrigation, municipal, industrial)

WELL COMPLETION DATA:

- (1) diameter (inches) 4
- (2) total depth (feet) 68
- (3) static water level (feet) 40 below top of ground.
- (4) casing (material) PVC, (depth) 60
4 (size) If telescope see back.
- (5) screen (length) 8, (depth to top) 60
4 (size), PVC (material)
- (6) pump 1/2 (HP), 10 (yield gpm)
Cali (type power)
- (7) electric log (yes or no)
- (organization running log)
- (8) how well bottom plugged

Miss. Board of Water Comm.


MAR 28 1979

RECEIVED

DRILLERS REMARKS:

If well telescopes please sketch and show depths.

GROUND LEVEL

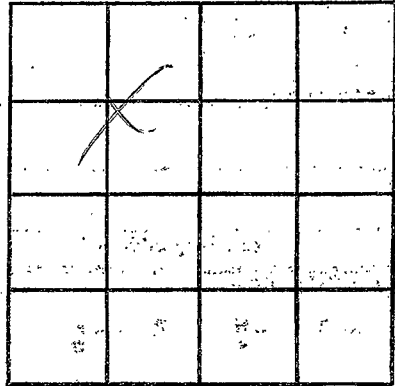

SECTION X-1

Please indicate well location Xc

ADDITIONAL INFORMATION

If more than one screen, show locations of each on sketch.