

Lincoln
P
2018
3-14-79
3-14

MISSISSIPPI
BOARD OF WATER COMMISSIONERS
416 North State Street
Jackson, Mississippi 39201

WATER WELL DRILLERS LOG

1979 Fitzgerald Well Serv Lincoln
date well completed firm name county well located

LANDOWNER:
Larry McCaffrey
Robt. Bonnell
(mailing address)

description of formations encountered	from	to
	<u>Red clay</u>	<u>0</u>
<u>Red sand</u>	<u>20</u>	<u>70</u>
<u>Coarse sand & gravel</u>	<u>70</u>	<u>91</u>

WELL LOCATION:
sec. 11 T. 5 N. R. 7 E.
1 miles W of Monticello
(distance) (direction) (nearest town)

WELL PURPOSE:
(home, irrigation, municipal, industrial)

- WELL COMPLETION DATA:
- (1) diameter (inches) 4
 - (2) total depth (feet) 91
 - (3) static water level (feet) 60 below top of ground.
 - (4) casing 4" PVC 83'
(material) (depth)
4 (size) if telescope see back.
 - (5) screen 8" 83'
(length) (depth to top)
4 (size) (material)
 - (6) pump 1/2 HP 10 yield gpm
(HP) (yield gpm)
Electric (type power)
 - (7) electric log no
(yes or no)
(organization running log)
 - (8) how well bottom plugged Level 83'

DRILLERS REMARKS:


Miss. Board of Water Comm.

MAR 28 1979

RECEIVED

If well telescopes please sketch and show depths.

GROUND LEVEL

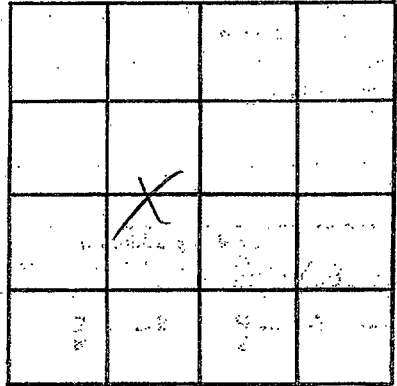

SECTION 11

Please indicate well location X.

ADDITIONAL INFORMATION

If more than one screen, show locations of each on sketch.