

Lincoln
P2023
8-8-79

MISSISSIPPI
 BOARD OF WATER COMMISSIONERS
 416 North State Street
 Jackson, Mississippi 39201

WATER WELL DRILLERS LOG

8-8 19 79 Fitzgerald Well Serv Lincoln
 date well completed firm name county well located

LANDOWNER:	description of formations encountered	from	to
<u>Wilford Adams</u>			
<u>R.R. Summit, Ms.</u> (mailing address)	<u>Red Clay</u>	<u>0</u>	<u>20</u>
	<u>Red Sand</u>	<u>20</u>	<u>80</u>
	<u>Coarse sand & gravel</u>	<u>80</u>	<u>92</u>
WELL LOCATION: sec. <u>29</u> T <u>5</u> N R <u>7</u> E S W			
<u>7</u> miles <u>NNW</u> of <u>Summit</u> (distance) (direction) (nearest town)			
WELL PURPOSE: <u>Home</u> (home, irrigation, municipal, industrial)			
WELL COMPLETION DATA: (1) diameter (inches) <u>4</u>			
(2) total depth (feet) <u>92</u>			
(3) static water level (feet) <u>65</u> below top of ground.			
(4) casing <u>PVC</u> , <u>84</u> , (material) (depth)			
<u>4</u> (size) if telescope see back.			
(5) screen <u>8</u> , <u>84</u> (length) (depth to top)			
<u>4</u> , <u>PVC</u> (size) (material)			
(6) pump <u>1/2</u> , <u>10</u> (HP) (yield gpm)			
<u>elec</u> (type power)			
(7) electric log <u>ye</u> (yes or no)			
(8) how well bottom plugged <u>Seal</u>			
DRILLERS REMARKS:			


Miss. Board of Water Comm.

SEP 12 1979

RECEIVED

If well telescopes please sketch and show depths.

GROUND LEVEL

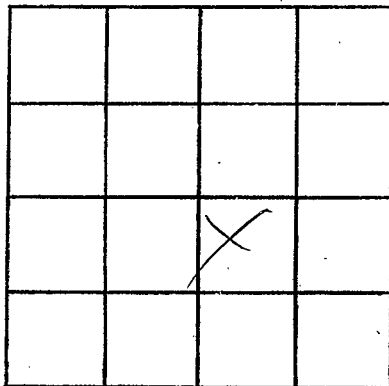

SECTION 29

Please indicate well location X.

ADDITIONAL INFORMATION

If more than one screen, show locations of each on sketch.