

Lincoln
P
2004
5-12-79

MISSISSIPPI
 BOARD OF WATER COMMISSIONERS
 416 North State Street
 Jackson, Mississippi 39201

WATER WELL DRILLERS LOG

date well completed May 12 1979 firm name Reems Well Service county well located Lincoln

LANDOWNER:
Montgomery Ball Field
At: Bogue Chitto
 (mailing address)

description of formations encountered	from	to
<u>Clay</u>	<u>0</u>	<u>17</u>
<u>Chalk sand</u>	<u>17</u>	<u>60</u>
<u>Plagiosand & sand</u>	<u>60</u>	<u>79</u>

WELL LOCATION:
 sec. 28 T. 5 N R. 7 E
7 miles N-NW of Summit
 (distance) (direction) (nearest town)

WELL PURPOSE: ball park
 (home, irrigation, municipal/industrial)

WELL COMPLETION DATA:
 (1) diameter (inches) 4"
 (2) total depth (feet) 79
 (3) static water level (feet) 58' below above top of ground.
 (4) casing plastic bottom
 (material) (depth)
 (size) if telescope see back.
 (5) screen 5' 74'
 (length) (depth to top)
4" plastic
 (size) (material)
 (6) pump be. alphas
 (HP) (yield gpm)
elect
 (type power)
 (7) electric log no
 (yes or no)
 (organization running log)

(8) how well bottom plugged
wooden plug
 DRILLERS REMARKS:


DEPT. OF NATURAL RESOURCES
 BUREAU OF LAND & WATER RESOURCES

OCT 10 1979

RECEIVED

If well telescopes please sketch and show depths.

GROUND LEVEL

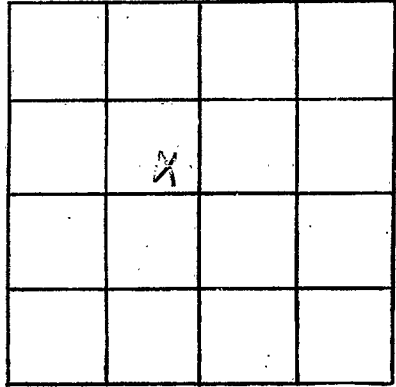

SECTION 28

Please indicate well location X.

ADDITIONAL INFORMATION

If more than one screen, show locations of each on sketch.