

Lincoln
P
2026
10-19-79

MISSISSIPPI
 BOARD OF WATER COMMISSIONERS
 416 North State Street
 Jackson, Mississippi 39201

WATER WELL DRILLERS LOG

10-19 19 79 Fitzgerald Well Serv Lincoln
 date well completed firm name county well located

LANDOWNER:	description of formations encountered	from	to
<u>Ray Moak</u>	<u>Reel clay</u>	<u>0</u>	<u>20</u>
<u>RR. Boque Chitto</u> (mailing address)	<u>Reel sand</u>	<u>20</u>	<u>50</u>
WELL LOCATION: sec. <u>16</u> T. <u>5</u> N. R. <u>7</u> E. S. W.	<u>Coarse sandstone</u>	<u>50</u>	<u>60</u>
WELL PURPOSE: <u>Home</u> (home, irrigation, municipal, industrial)			
WELL COMPLETION DATA:			
(1) diameter (inches) <u>4</u>			
(2) total depth (feet) <u>60</u>			
(3) static water level (feet) <u>35</u> below top of ground.			
(4) casing <u>PVC</u> , <u>52</u> , (material) (depth) <u>4</u> (size) if telescope see back.			
(5) screen <u>8</u> , <u>52</u> (length) (depth to top)			
(6) pump <u>4</u> , <u>PVC</u> (size) (material)			
(7) pump <u>1/2</u> , <u>10</u> (HP) (yield gpm)			
<u>Elc</u> (type power)			
(7) electric log <u>No</u> (yes or no)			
(organization running log)			
(8) how well bottom plugged <u>Sand shh.</u>			
DRILLERS REMARKS:			


DEPT. OF NATURAL RESOURCES
 BUREAU OF LAND & WATER RESOURCES

NOV - 7 1979

RECEIVED

If well telescopes please sketch and show depths.

GROUND LEVEL

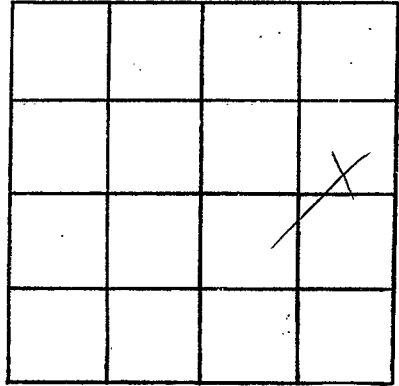

SECTION 10

Please indicate well location X.

ADDITIONAL INFORMATION

If more than one screen,
show locations of each on sketch.