

Linked LN
P 2027

MISSISSIPPI
 BOARD OF WATER COMMISSIONERS
 416 North State Street
 Jackson, Mississippi 39201

WATER WELL DRILLERS LOG

3-14 1980 Fitzgerald Dr Lineal
 date well completed firm name county well located

LANDOWNER:	description of formations encountered	from	to
<u>Don Dierline</u>			
<u>P.R. - Bonnetts</u> (mailing address)	<u>Reel clay</u>	<u>0</u>	<u>20</u>
	<u>Reel sand</u>	<u>20</u>	<u>50</u>
	<u>Coarse sand & gravel</u>	<u>50</u>	<u>72</u>
WELL LOCATION: sec. <u>20</u> T. <u>S</u> N. R. <u>7</u> E. S W			
<u>6</u> miles <u>E</u> of <u>Cuburn</u> (distance) (direction) (nearest town)			
WELL PURPOSE: <u>Home</u> (home, irrigation, municipal, industrial)			
WELL COMPLETION DATA:			
(1) diameter (inches) <u>4</u>			
(2) total depth (feet) <u>72</u>			
(3) static water level (feet) <u>52</u> below top of ground.			
(4) casing <u>PVC 64</u> , (material) (depth) <u>4</u> if telescope see back. (size)			
(5) screen <u>8</u> <u>64</u> (length) (depth to top) <u>4</u> , <u>PVC</u> (size) (material)			
(6) pump <u>1/2</u> <u>10</u> (HP) (yield gpm) <u>Electric</u> (type power)			
(7) electric log <u>no</u> (yes or no)			
(organization running log)			
(8) how well bottom plugged <u>Sand sh</u>			

DRILLERS REMARKS:


DEPT. OF NATURAL RESOURCES
 BUREAU OF LAND & WATER RESOURCES

MAR 25 1980

RECEIVED

If well telescopes please sketch and show depths.

GROUND LEVEL

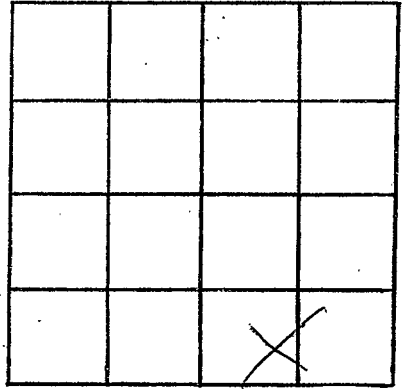

SECTION 20

Please indicate well location X.

ADDITIONAL INFORMATION

If more than one screen,
show locations of each on sketch.