

Lincoln
P 2088
1-14-80

MISSISSIPPI
BOARD OF WATER COMMISSIONERS
416 North State Street
Jackson, Mississippi 39201

WATER WELL DRILLERS LOG

1-14 1980 Int'l Groundwater Services Lincoln
date well completed firm name county well located

LANDOWNER:	description of formations encountered	from	to
Montgomery church			
R.R. Rozee Clitto (mailing address)	Red clay Red sand	0 20	20 65
WELL LOCATION:	Coarse sand & gravel	65	88
sec. 28 T. 5(N) S. R. 7(E) W. 7 miles N of Summit (distance) (direction) (nearest town)			
WELL PURPOSE: (home, irrigation, municipal, industrial)			
WELL COMPLETION DATA:			
(1) diameter (inches) 4			
(2) total depth (feet) 88			
(3) static water level (feet) 65 below top of ground.			
(4) casing PVC, 80 (material), (depth)			
4 (size) If telescope see back.			
(5) screen 8, 80 (length), (depth to top)			
4 (size), PVC (material)			
(6) pump 1/2 (HP), 10 (yield gpm)			
Ela (type power)			
(7) electric log no (yes or no)			
(organization running log)			
(8) how well bottom plugged sand slab			
DRILLERS REMARKS:			


DEPT. OF NATURAL RESOURCES
BUREAU OF LAND & WATER RESOURCES

JAN 31 1980

RECEIVED

If well telescopes please sketch and show depths.

GROUND LEVEL

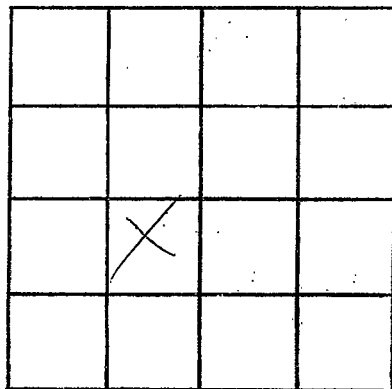

SECTION 28

Please indicate well location X.

ADDITIONAL INFORMATION

If more than one screen,
show locations of each on sketch.