

BOARD OF WATER COMMISSIONERS
416 North State Street
Jackson, Mississippi 39201

WATERWELL
P 2031
8-30-79

WATER WELL DRILLERS LOG

Aug 30 19 79 Bevers Well Drilling Lincoln
date well completed firm name county well located

LANDOWNER:

J. D. M. instead
Rt. Summit
(mailing address)

description of formations encountered

from to

Clay	0	18
red sand	18	35
blue chalk	35	60
white sand	60	75
blue chalk	75	110
Coarse yellow sand	110	120

WELL LOCATION:

sec. 26 T 5 N R 7 E
6 miles north of Summit
(distance) (direction) (nearest town)

WELL PURPOSE:

Trailer
(home, irrigation, municipal, industrial)

WELL COMPLETION DATA:

- (1) diameter (inches) 4"
- (2) total depth (feet) 120
- (3) static water level (feet) 81 below above top of ground.
- (4) casing plastic bottom
(material) (depth)
- (size) if telescope see back.
- (5) screen 5' 115'
(length) (depth to top)
- 4" plastic
(size) (material)
- (6) pump 1/2 hp aluminum
(HP) (yield gpm)
- split
(type power)
- (7) electric log no
(yes or no)
- (organization running log)

(8) how well bottom plugged
wood plug

DRILLERS REMARKS:


DEPT. OF NATURAL RESOURCES
BUREAU OF LAND & WATER RESOURCES

JUN 25 1980

RECEIVED

If well telescopes please sketch and show depths.

GROUND LEVEL

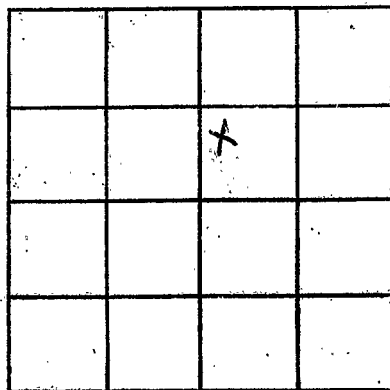

SECTION 26

Please indicate well location X.

ADDITIONAL INFORMATION

If more than one screen, show locations of each on sketch.