

LINCOLN
P 2032
9-12-80

MISSISSIPPI
BOARD OF WATER COMMISSIONERS
416 North State Street
Jackson, Mississippi 39201

WATER WELL DRILLERS LOG

9-12
date well completed

1980 *Fleming*
firm name

Lincoln
county well located

LANDOWNER:	description of formations encountered	from	to
<i>John Ralcliff</i> <i>R.R. Boyce Clitto</i> (mailing address)			
WELL LOCATION: sec. <u>1</u> T. <u>6</u> S. R. <u>7</u> E. <i>1.4</i> miles (distance) <u>W</u> (direction) of <i>Boyce Clitto</i> (nearest town)			
WELL PURPOSE: <u>Home</u> (home, irrigation, municipal, industrial)			
WELL COMPLETION DATA: (1) diameter (inches) <u>4</u> (2) total depth (feet) <u>235</u> (3) static water level (feet) <u>50</u> below above top of ground. (4) casing <u>4</u> (material) <u>227</u> (depth), <u>4</u> (size) if telescope see back. (5) screen <u>8</u> (length), <u>227</u> (depth to top), <u>4</u> (size), <u>402</u> (material) (6) pump <u>1/2</u> (HP), <u>10</u> (yield gpm), <u>the</u> (type power) (7) electric log <u>no</u> (yes or no) (organization running log) (8) how well bottom plugged <u>Sallet</u>			

DEPT. OF NATURAL RESOURCES
BUREAU OF LAND & WATER RESOURCES


DRILLERS REMARKS:

DEC - 9 1980

RECEIVED

If well telescopes please sketch and show depths.

GROUND LEVEL

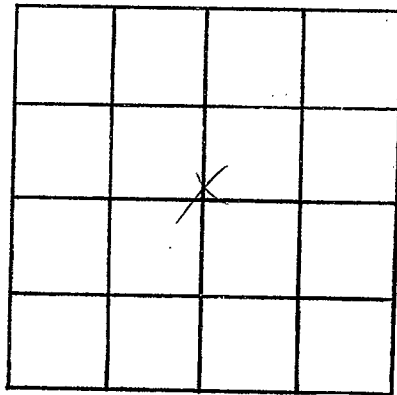

SECTION 1

Please indicate well location X.

ADDITIONAL INFORMATION

If more than one screen,
show locations of each on sketch.