

Lincoln
Rt 2033
5/9/81

MISSISSIPPI
BOARD OF WATER COMMISSIONERS
416 North State Street
Jackson, Mississippi 39201

WATER WELL DRILLERS LOG

date well completed May 6 1981 firm name 81 Bromfield Well Service Limited county well located Lincoln

LANDOWNER: Ralph Trastie
Rt. 3
Boque Chitts, Ms.
(mailing address)

description of formations encountered	from	to
Surface Clay		
Sand	0	12
Gravel	12	22
Tight Sand	22	37
Clay	37	42
Sand	42	95
Sand & Rock	95	98


WELL LOCATION:
sec. 23 T 5 N R. 7 E
3 1/2 miles S of Boque
(distance) (direction) (nearest town)

WELL PURPOSE: same
(home, irrigation, municipal, industrial)

- WELL COMPLETION DATA:
- (1) diameter (inches) 4
 - (2) total depth (feet) 98
 - (3) static water level (feet) 30 below above top of ground.
 - (4) casing Plastic, 88'
(material) (depth)
4" if telescope see back.
(size)
 - (5) screen 10' 88'
(length) (depth to top)
4" Plastic
(size) (material)
 - (6) pump 1/2 Jet, 3 1/2
(HP) (yield gpm)
electric
(type power)
 - (7) electric log no
(yes or no)


(organization running log)
(8) how well bottom plugged Sandstone

DRILLERS REMARKS:

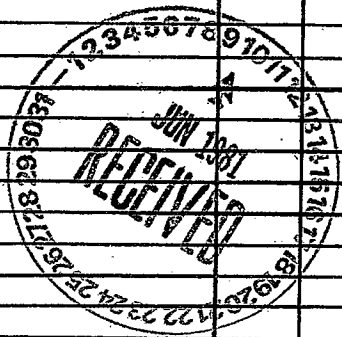

If well telescopes please
sketch and show depths.

GROUND LEVEL

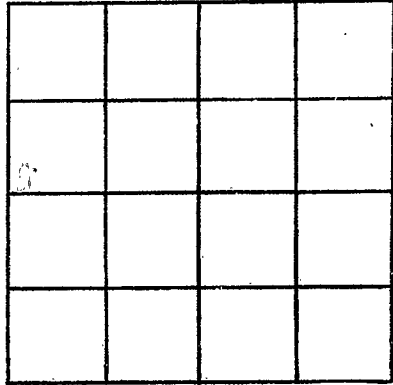

SECTION 23

Please indicate well location X.

ADDITIONAL INFORMATION

If more than one screen,
show locations of each on sketch.