

LINCOLN  
P  
2035

MISSISSIPPI  
BOARD OF WATER COMMISSIONERS  
416 North State Street  
Jackson, Mississippi 39201

WATER WELL DRILLERS LOG

11-26  
date well completed

1981 Fitzgibbon well serv  
firm name

Lincoln  
county well located

LANDOWNER:	description of formations encountered	from	to
<u>M. V. Reeves</u>			
<u>R.R. Bogue chills</u> (mailing address)	<u>Red clay</u>	<u>6</u>	<u>20</u>
	<u>Red sand</u>	<u>20</u>	<u>75</u>
	<u>Coarse sand &amp; gravel</u>	<u>45</u>	<u>70</u>
<b>WELL LOCATION:</b>			
sec. <u>28</u> T <u>S</u> N R <u>2</u> E			
S W			
<u>5</u> miles <u>W</u> of <u>Summit</u>			
(distance) (direction) (nearest town)			
<b>WELL PURPOSE:</b> <u>Home</u> (home, irrigation, municipal, industrial)			
<b>WELL COMPLETION DATA:</b>			
(1) diameter (inches) <u>4</u>			
(2) total depth (feet) <u>70</u>			
(3) static water level (feet) <u>40</u> below top of ground.			
(4) casing <u>PVC</u> , <u>62</u> , (material) (depth)			
<u>4</u> If telescope see back. (size)			
(5) screen <u>8</u> , <u>62</u> (length) (depth to top)			
<u>4</u> , <u>PVC</u> (size) (material)			
(6) pump <u>1/2</u> , <u>10</u> (HP) (yield gpm)			
<u>elec</u> (type power)			
(7) electric log <u>No</u> (yes or no)			
(8) how well bottom plugged <u>hard plug</u>			
<b>DRILLERS REMARKS:</b>			


DEPT. OF NATURAL RESOURCES  
BUREAU OF LAND & WATER

JAN 15 1982

RECEIVED

If well telescopes please sketch and show depths.

GROUND LEVEL

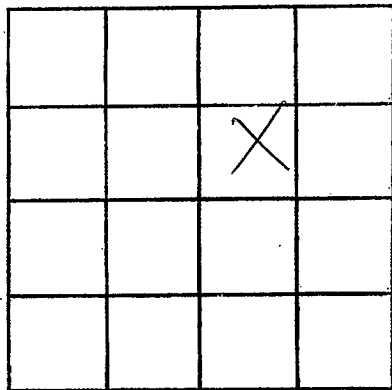

SECTION 28

Please indicate well location X.

ADDITIONAL INFORMATION

If more than one screen, show locations of each on sketch.