

Line
P
2036

MISSISSIPPI
 BOARD OF WATER COMMISSIONERS RURAL RESOURCES
 416 North State Street BUREAU OF LAND & WATER RESOURCES
 Jackson, Mississippi 39201

MAR 22 1982

WATER WELL DRILLERS LOG

Feb. 8 19 82 Brentwood **RECEIVED**
 date well completed firm name county well located

LANDOWNER: Larry Keebles
Re. 3
Boothe Chitto Miss
 (mailing address)

description of formations encountered	from	to
CIAU	0	12
CIAU + Sand	12	31
Tight Sand	31	57
SAND PACK	57	57 1/2
CIAU	57 1/2	65
SAND + PACK	65	70
Loose clay	70	85
WATER SAND	85	100

WELL LOCATION:
 sec. 20 T 5 N R 7 E
5 miles SW of Norfield
 (distance) (direction) (nearest town)


WELL PURPOSE: Home
 (home, irrigation, municipal, industrial)

- WELL COMPLETION DATA:
- (1) diameter (inches) 4"
 - (2) total depth (feet) 100
 - (3) static water level (feet) 65 below top of ground.
 - (4) casing 90' Plastic
 (material) (depth)
4" If telescope see back.
 (size)
 - (5) screen 10' 90'
 (length) (depth to top)
4" Plastic
 (size) (material)
 - (6) pump 1/2 Jor 3
 (HP) (yield gpm)
Electric
 (type power)
 - (7) electric log NO
 (yes or no)
 - (8) how well bottom plugged SAND STRAIN

DRILLERS REMARKS:

If well telescopes please sketch and show depths.

GROUND LEVEL

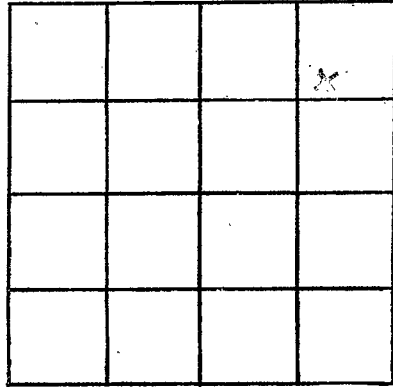

SECTION 20

Please indicate well location X.

ADDITIONAL INFORMATION

If more than one screen,
show locations of each on sketch.